

LEAKE
F210

WATER WELL DRILLERS LOG

CODED

Date: 2-23, 1966, Driller: J P Sherman County Shore
2-23-66 (Name)

(1) Owner of Land:	Description & Color of Materials Sand, Clay, Red Clay, Shell, etc.	Thick- ness Feet	Depth Feet
<u>W E Miller</u> (Name)	<u>red clay</u>	<u>20</u>	
<u>Carthage Miss</u> (Address)	<u>dry sand</u>	<u>29</u>	
(2) Location: <u>1/4</u> , <u>14 11 7</u> Sec. <u>T</u> <u>R</u>	<u>gray water sand</u>	<u>18</u>	
<u>7</u> miles <u>N.</u> of <u>Carthage</u> (distance) (direction) (Nearest Town)			
(3) Topography: <u>Hilly</u> (Hilly) (Flat) (Level)	<u>898</u>		
(4) Purpose of Well: <u>Domestic</u> (Domestic Irrigation Municipal, Industrial, Other)			


Information upon completion of well:

- (1) Diameter 2 inches.
- (2) Total Depth 67 feet.
- (3) Water Level 33 feet below top of ground.
- (4) Cased to 63, Size 2
- (5) Screen: Size 1 1/4, Length 4
- (6) Were any formations sealed against pollution?
_____ yes, _____ no.

If YES depth of formation _____

Why _____

Drillers Remarks: 300 gal per hr

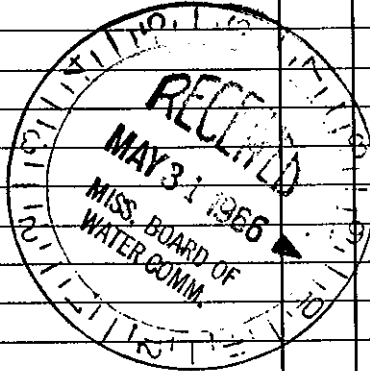

Well No.

(Use Back Side)

Mail this copy to Board of Water Commissioners 429 Miss. St. Jackson, Miss.