

LEAKE MISSISSIPPI BOARD OF WATER COMMISSIONERS

F23  
2-25-64

WATER WELL DRILLERS LOG

CODED

Date: 2-25, 1964, Driller: J P Thornton County Leake

(Name)

(1) Owner of Land: Fred Sero.  
(Name)  
Carthage miss  
(Address)  
(2) Location: 1/4, 28 11 7  
4 miles N.W. of Carthage,  
(distance) (direction) (Nearest Town)  
(3) Topography: hilly  
(Hilly) (Flat) (Level)  
(4) Purpose of Well: Domestic  
(Domestic Irrigation  
Municipal, Industrial, Other)

Description & Color of Materials Sand, Clay, Red Clay, Shell, etc.	Thick- ness Feet	Depth Feet
red clay	50	
blue chalk	40	
rock	4	
dark green sand	10	
black dirt	75	
rock	2	
black sand	30	
rock	3	
fine gray sand	15	
blue chalk	3	
coarse gray water sand	21	
	263	


Information upon completion of well:

(1) Diameter 2 inches.  
(2) Total Depth 263 feet.  
(3) Water Level 100 feet below top of ground.  
(4) Cased to 258, Size 2"  
(5) Screen: Size 1/4, Length 6 ft.  
(6) Were any formations sealed against pollution?  
yes, no.

If YES depth of formation

Why

Drillers Remarks: 800 gal per hr.

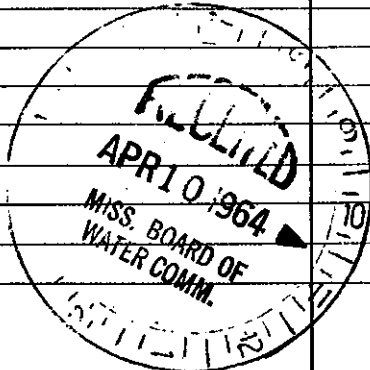

(Use Back Side)

Well No.

Mail this copy to Board of Water Commissioners 429 Miss. St. Jackson, Miss.