

Leake
F28 CODED
6-68

MISSISSIPPI
BOARD OF WATER COMMISSIONERS
416 North State Street
Jackson, Mississippi 39201

WATER WELL DRILLERS LOG

6-9-1968 date well completed
M. S. F. Drillers, Leake firm name
Leake county well located


LANDOWNER	description of formations encountered	from	to
Carl Kitchener	Red Clay	0	10
M. S. F. Drillers, Leake (mailing address)	Black Clay	10	58
	Red Sand	54	60
	Black Clay	65	80
	White Sand	80	127

WELL LOCATION:
sec. 3 T. 11 N R. 7 E
S W
(distance) miles 7 1/2 of Cuthbert (direction) (nearest town)

WELL PURPOSE: Home
(home, irrigation, municipal, industrial)

- WELL COMPLETION DATA:
- (1) diameter (inches) 3 7/8
 - (2) total depth (feet) 127
 - (3) static water level (feet) 42 below top of ground.
 - (4) casing 1 1/2" (material), 121 1/2' (depth)
 - (size) If telescope see back.
 - (5) screen 1 1/2" x 6' (length), (depth to top)
 - 1 1/2" (size), Mesh screen (material)
 - (6) pump 3/4 (HP), (yield gpm)
 - Electric (type power)
 - (7) electric log No (yes or no)
 - (organization running log)
 - (8) how well bottom plugged

CODED

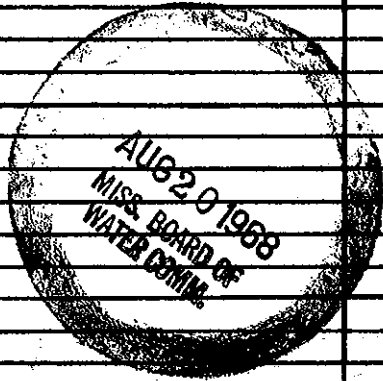

DRILLERS REMARKS: