

LEAKE #30 WATER WELL DRILLERS LOG


Date: 11-4-61, 1961, Driller: J.P. Thornton County Leake
 (Name) William Dickens

	Description & Color of Materials Sand, Clay, Red Clay, Shell, etc.	Thick- ness Feet	Depth Feet
(1) Owner of Land: _____ (Name)	<u>Red Clay</u>	<u>10</u>	
<u>Carthage Miss</u> (Address)	<u>White Clay</u>	<u>9</u>	
(2) Location: _____ 1/4, _____ 1/4, Sec. <u>19</u> T. <u>11</u> N. R. <u>7E</u>	<u>Brown sand</u>	<u>14</u>	
<u>4</u> miles <u>NW</u> of <u>Chick</u>	<u>Pink sand</u>	<u>6</u>	
(distance) (direction) (Nearest Town)	<u>White sand</u>	<u>7</u>	
(3) Topography: <u>Hilly</u>			
(Hilly) (Flat) (Level)			
(4) Purpose of Well: <u>Domestic</u>			
(Domestic Irrigation Municipal, Industrial, Other)			

Information upon completion of well:

- (1) Diameter 2 inches.
- (2) Total Depth 46 feet.
- (3) Water Level 37 feet below top of ground.
- (4) Cased to 46, Size 2"
- (5) Screen: Size 1 1/4, Length 6 ft
- (6) Were any formations sealed against pollution?
 yes, no.

If YES depth of formation _____
 Why _____
 Drillers Remarks: 35-^{gal} DPs hr.

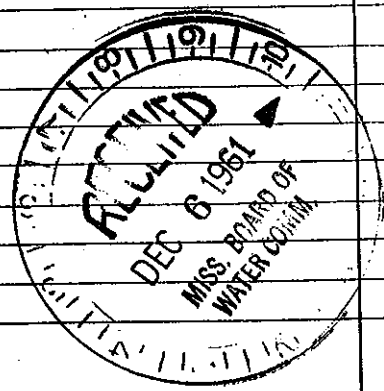

(Use Back Side)

Well No. _____

Retain this copy for your office files.