
	7 State V	Vell Report		
County:		Part 1	For Office Use Only:	
Permit #:	Mississippi Department of Environmental Quality		-	
	Office of Land	and Water Resources	Aquifer:	
Driller: Legar Drilling	P.O. 1	Box 10631	Well #: F- 33	
Date drilling completed: 2/22/0 8	Jackson, N	AS 39289-0631	7 0 79	
	(601)	961-5210	L. S. Elevation:	
C4 4 X	(601)35	4-6938 (fax)	E-log #:	
State Law requires that this repo	ort be prepared by the	driller in detail and en a		
Well Owner Informa	of the well.		Ith the Department within	
Owner Name		Well	Location	
Owner Name erry Rabinson				
Mailing Address: 12 Rd 1543			" Longitude:"	
Method of Lat/Long (circle one		e): Conventional Survey		
Ciny Ms	38804	USGS quad, Hand-held	GPS, Survey-grade GPS	
City State	c Zip Code	1/4 Sec_ Z	1 Twn 85 Rng 75	
Telephone No. (372 - 48		Distance Direction		
	//	Distance Direction Miles NE 0	Nearest Town	
	Well D	ato	- / upe / U	
Purpose of Well (circle one) Home Indus				
Day 11 and 1	smai Public Supply	Irrigation Fish Culture (Other:	
Date well drilling started: 2/2/0	Pate w	ell drillian and the second		
Date well drilling started: 2/21/0 If flowing, method of flow regulation: Value		ch drifting completed:	22/01	
B 1 111 4 C	Other (des	scribe)		
Static Water Level:feet above	e or below (circle one) la			
Static Water Level:				
(Siegi jane / Siegi jane / Sieg				
Hole depth: Well depth: Well grouted to a depth of/ 4feet Type of grout (circle one): Cement Part Part Part				
Type of grout (circle one): Cement		wen grouted to a depth of	feet	
Conicil	Bentonite (Mir)			
Casing length: 24 of feet Casing of	diameter: 4 "	inches To	00	
Screen length: 40 feet Screen		mones Type of casing:	700	
Scientification of the second	mameter:	inches Type of screen:	Pue	
Screen slot size:	Setting depth: From	24 y fact to 3	C	
Type of completion (circle all applicable):		1001 10	<u>fcct</u>	
Type of completion (circle all applicable): G	Underrease Underrease	med Telescoped Open hol	e Natural Development	
C	Other (describe):			
Top of lap pipe or reduction in casing:	£			
Top of lap pipe or reduction in casing:	icel. If teleso	coped or more than one screen,	describe on back of page	
Logs run (circle all applicable): No log run	Electric Gamma Ray D	ensity Sonic Neutron Orb		
I certify that the well was drilled, constructe	d, and completed in acco	rdance with all and the		
Department of Environmental Quality and/o	or the Mississinni Dancat	ment of It. 14	irements of the Mississippi	
Leeper Ville # 17	77-6	ment of Health regulations and	state laws.	
Leeper Drilling# 2	47 0079			
Print Name of Water Well Contractor and Lice	noe M.		yer	
Contactor and Lice	iis¢ iyo.	Signature of Was	er Well Contractor	

RECEIVED

MAR 1 0 2008

If well telescopes please sketch below and show depths.

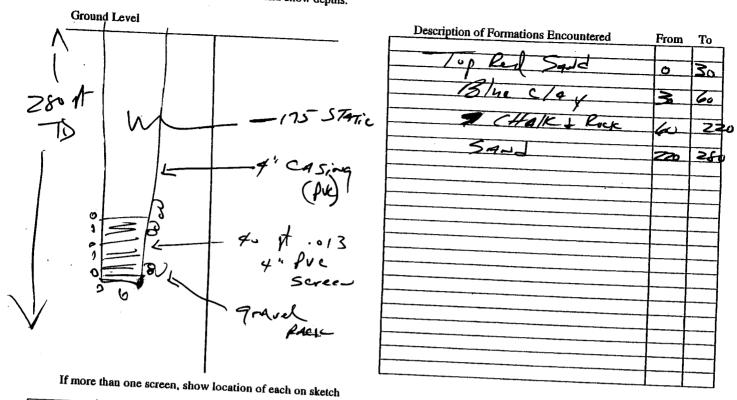

Sketch the property layout and include the following: 1) the well location; 2) any permanent structures on the property that may aid in locating the well; 3) any roads, power lines, or other items that may aid in locating the property and the well;

4) indicate direction.

Home

Landowner Name:

Landowner Name:

Landowner Name:

Signature of Water Well Contractor

RECEIVED

MAR 1 0 2008

BY: OLWR

STATE WELL REPORT

Part 2

County: Pump Installer's Completion Report Mississippi Department of Environmental Quality Permit #: Office of Land and Water Resources Driller: P.O. Box 10631 Jackson, MS 39289-0631 (601)961-5210

For Office Use Only:
Aquifer:
Well#: F · 33
Elevation:

Date completed: __ (601)354-6938 (fax) This report should be prepared by the pump installer in detail and filed with the Department within 30 days of the installation of pump. Well Owner Information Well Location Owner Name: Latitude:_ Longitude: Mailing Address: Method of Lat/Long (circle one): Conventional Survey, USGS quad, Hand-held GPS, Survey-grade GPS 4 Sec 27 Twn 8 S Rng 75 Distance Telephone No. (63 372 -4849 Direction & Miles NE of Tupelo Pump Type Circle one Power Type Circle one Air Lift Jet Submersible \ Diesel Engine Gasoline Engine Natural Gas Bucket Piston Turbine Electric Motor Hand Tractor PTO Centrifugal Rotary Flowing Well Windmill Other (specify): __ Other (specify): _ Horse Power Rating of Motor: _____/ + P 2/2 3/0 } Date Pump Installed: ____ Setting Depth: ___ 220 feet Rated Pump Capacity: _ Gallons Per Minute Number of Stages: _____/ 4

Pump Test Data	
Date Well Tested: 2/23/08	Method of Measuring Water Level Circle one
Static Water Level (A): Feet Below Land Surface	Air Line Electric Measuring Line Steel Tape
Pumping Water Level (B):Feet Below Land Surface	Other (specify):
Drawdown [(B) - (A)]:Feet Below Land Surface	For flowing well, measured shut in head:feet
Test Pumping Rate:Gallons Per Minute	Well yieldedGPM with a drawdown of
Duration of Pump Test (minimum 4 hours):hours	feet afterhours of pumping

İ	I HEREBY CERTIFY that the above statements are true to the best of my knowledge. Print Name of Pump Installer and License No. (if applicable)
	Signature of Pump Installer and License No. (if applicable) Signature of Pump Installer

RECEIVED