

LeAKE
F-43
7-8-66

MISSISSIPPI BOARD OF WATER COMMISSIONERS

WATER WELL DRILLERS LOG

CODED

Date: 7-8, 1966, Driller: J P Inman County Leake

(Name)

(1) Owner of Land: W. R. Burch
(Name)
Carthage miss
(Address)

(2) Location: 1/4, 1/4, Sec. 1 T 11 R 7
9 miles North, of Carthage
(distance) (direction) (Nearest Town)

(3) Topography: X
(Hilly) (Flat) (Level)

(4) Purpose of Well: Domestic
(Domestic Irrigation, Municipal, Industrial, Other)

Description & Color of Materials Sand, Clay, Red Clay, Shell, etc.	Thick- ness Feet	Depth Feet
<u>red clay</u>	<u>21</u>	
<u>dry sand</u>	<u>28</u>	
<u>white chalk</u>	<u>2</u>	
<u>white water sand</u>	<u>6</u>	<u>s</u>
	<u>57</u>	

Information upon completion of well:

(1) Diameter 2 inches.

(2) Total Depth 57 feet.

(3) Water Level 32 feet below top of ground.

(4) Cased to 5', Size 2"

(5) Screen: Size 1/4, Length 6'


(6) Were any formations sealed against pollution?
_____ yes, _____ no.

If YES depth of formation _____

Why _____

Drillers Remarks: 400 gal per hr

CODED

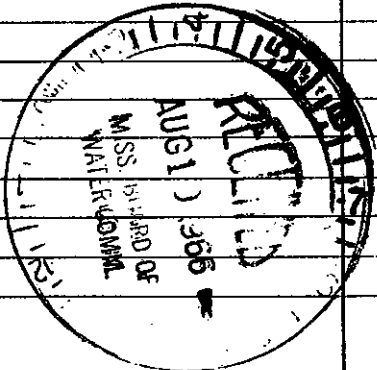

(Use Back Side)

Well No.