

WATER WELL DRILLERS LOG

Date: 7-20, 1962, Driller: Hearon Drilling County Leake  
 (Name)

(1) Owner of Land: <u>Arbor Acres Farm, Miss. Division</u> (Name)	Description & Color of Materials Sand, Clay, Red Ciy, Shell, etc.	Thick- ness Feet	Depth Feet
<u>Carthage, Miss.</u> (Address)	<u>Red-yellow clay</u>	<u>14</u>	<u>14</u>
(2) Location: <u>SW 1/4, SW 1/4, Sec. 32 T11 R 8</u>	<u>Red Sand</u>	<u>26</u>	<u>40</u>
(3) Topography: <u>1 3/4 miles E of Carthage</u> (distance) (direction) (Nearest Town)	<u>cream water sand</u>	<u>14</u>	<u>54</u>
(3) Topography: <u>Hilly</u> (Hilly) (Flat) (Level)	<u>White Sand</u>	<u>26</u>	<u>80</u>
(4) Purpose of Well: <u>Industrial</u> (Domestic Irrigation Municipal, Industrial, Other)	<u>Tan Sand</u>	<u>9</u>	<u>89</u>
	<u>Yellow Sand</u>	<u>1</u>	<u>99</u>
	<u>Dark red Sand</u>	<u>1</u>	<u>100</u>
	<u>Dark grey clay</u>	<u>8</u>	<u>108</u>
	<u>Dark grey silt</u>	<u>13</u>	<u>121</u>
	<u>Dark grey clay</u>	<u>64</u>	<u>185</u>
	<u>Rock</u>	<u>22</u>	<u>207</u>
	<u>Lime Stone</u>	<u>12</u>	<u>219</u>
	<u>Rock</u>	<u>6</u>	<u>225</u>
	<u>Limestone Green</u>	<u>22</u>	<u>247</u>
	<u>Light Grey Sand</u>	<u>25</u>	<u>272</u>


Information upon completion of well:

- (1) Diameter 2 1/2 inches.
- (2) Total Depth 265 1/2 feet.
- (3) Water Level 38 feet below top of ground.
- (4) Cased to 263, Size 2 1/2" x 2"
- (5) Screen: Size 2 1/2" OD, Length 5 ft
- (6) Were any formations sealed against pollution?  
 yes,  no.

If YES depth of formation \_\_\_\_\_

Why \_\_\_\_\_

Drillers Remarks: \_\_\_\_\_

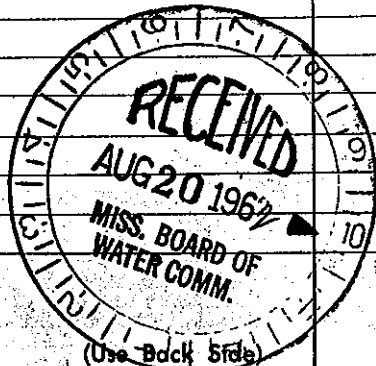

Well No. \_\_\_\_\_