

MISSISSIPPI BOARD OF WATER COMMISSIONERS

LEAKE
 # G10
 3-25-63

WATER WELL DRILLERS LOG

CODED

Date: 3-25, 1963, Driller: J P Thornton County Leake
 (Name)

(1) Owner of Land: <u>Sam Kemp</u> (Name)	Description & Color of Materials Sand, Clay, Red Clay, Shell, etc.	Thick- ness Feet	Depth Feet
<u>Carthage miss</u> (Address)	<u>Gunbo Chalk</u>	<u>30</u>	
(2) Location: <u>1/4, 1 1/4, Sec. 11 8</u> T. R.	<u>shell Rock</u>	<u>3</u>	
<u>5</u> miles <u>N.</u> of <u>Carthage</u> (distance) (direction) (Nearest Town)	<u>white Chalk</u>	<u>10</u>	
(3) Topography: <u>Hilly Domestic</u> (Hilly) (Flat) (Level)	<u>Real coarse sand</u>	<u>10</u>	
(4) Purpose of Well: <u>Domestic</u> (Domestic Irrigation Municipal, Industrial, Other)	<u>Black dirt</u>	<u>80</u>	
	<u>Rock</u>	<u>3</u>	
	<u>dark gray</u>	<u>12</u>	
	<u>Rock</u>	<u>1 1/2 ft</u>	
	<u>green sand</u>	<u>19 1/2</u>	
		<u>168</u>	

Information upon completion of well:


- (1) Diameter 2 inches.
- (2) Total Depth 168 feet.
- (3) Water level 68 feet below top of ground.
- (4) Cased to 147, Size 6 ft.
- (5) Screen: Size 1 1/4, Length 6 ft.
- (6) Were any formations sealed against pollution?
 _____ yes, _____ No.

If YES depth of formation _____

Why _____

Drillers Remarks: 360 gal per hr.

2107

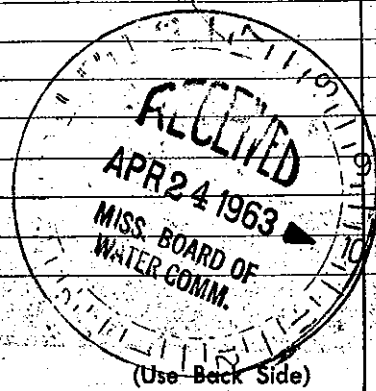

Well No.