

LEAKE MISSISSIPPI BOARD OF WATER COMMISSIONERS

G11

CODED

WATER WELL DRILLERS LOG

2-14-64

Date: 2-14, 1964, Driller: J.P. Thornton County Leake

(Name)


(1) Owner of Land: Leon Bell
(Name)
Carthage miss
(Address)
(2) Location: 3 1/4 1/4, 118 Sec. T. R.,
5 miles NE of Carthage
(distance) (direction) (Nearest Town)
(3) Topography: hilly
(Hilly) (Flat) (Level)
(4) Purpose of Well: Domestic
(Domestic Irrigation
Municipal, Industrial, Other)

Description & Color of Materials Sand, Clay, Red Clay, Shell, etc.	Thick- ness Feet	Depth Feet
red clay	43	
dry sand	38	81
white sand with little water	6	87
Blue chert	50	137
rock	3	140
Black dirt	40	180
Rock	3	183
gray water sand	22	205
	205	

Information upon completion of well:

(1) Diameter 2 inches.
(2) Total Depth 205 feet.
(3) Water Level 87 feet below top of ground.
(4) Cased to 174, Size 2"
(5) Screen: Size 1 1/4, Length 6
(6) Were any formations sealed against pollution?
_____ yes, _____ no.
If YES depth of formation _____

Why _____
Drillers Remarks: 325 gal per hr.

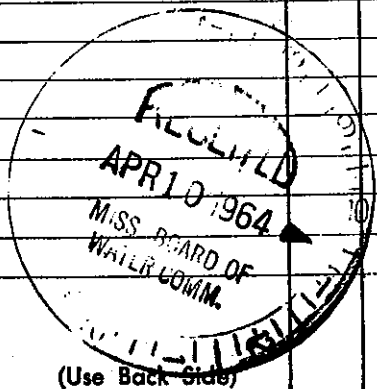

Well No.

Mail this copy to Board of Water Commissioners 429 Miss. St. Jackson, Mis: