

LEAKE
G12

WATER WELL DRILLERS LOG

CODED

Date: 3-26-63 Driller: J P Thornton County Leake
(Name)

	Description & Color of Materials Sand, Clay, Red Clay, Shell, etc.	Thick- ness Feet	Depth Feet
(1) Owner of Land: <u>H L Donald</u> (Name)	<u>gumbo</u>	<u>25</u>	
<u>Carthage miss</u> (Address)	<u>fine sand dug</u>	<u>40</u>	
(2) Location: <u>1/4, 26, Sec. 118</u> T R	<u>white chalk</u>	<u>4</u>	
<u>3</u> miles <u>SW</u> of <u>Carthage</u> (distance) (direction) (Nearest Town)	<u>white core sand</u>	<u>21</u>	
(3) Topography: <u>Hilly</u> (Hilly) (Flat) (Level)		<u>90</u>	
(4) Purpose of Well: <u>Domestic</u> (Domestic Irrigation Municipal, Industrial, Other)	<u>1306</u>		


Information upon completion of well:

- (1) Diameter 2 inches.
- (2) Total Depth _____ feet.
- (3) Water Level 90 feet below top of ground.
- (4) Cased to 85', Size 2
- (5) Screen: Size 1 1/4, Length 6ft
- (6) Were any formations sealed against pollution?
_____ yes, _____ No.

If YES depth of formation _____

Why _____

Drillers Remarks: 340 gal per hr
61395
20

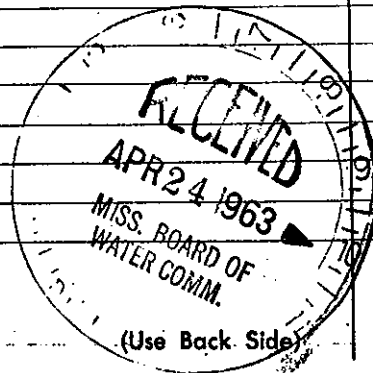

Well No.

Retain this copy for your office files.