

MISSISSIPPI BOARD OF WATER COMMISSIONERS


LEAKE
G 13
10-30-63

WATER WELL DRILLERS LOG

CODED

Date: 10-30, 1963, Driller: J P Shannon County Leake
(Name)

(1) Owner of Land:	Description & Color of Materials Sand, Clay, Red Clay, Shell, etc.	Thick- ness Feet	Depth Feet
<u>Carlton Boger</u> (Name)	<u>red clay</u>	<u>38</u>	
<u>Corchog</u> (Address)	<u>dry pin's fine sand</u>	<u>20</u>	
(2) Location: <u>29 11 8</u> 1/4, 1/4, Sec. T. R.	<u>chalk white</u>	<u>3</u>	
<u>3</u> miles <u>NE</u> of <u>Corchog</u> (distance) (direction) (Nearest Town)	<u>yellow fine sand</u>	<u>25</u>	
(3) Topography: <u>hilly</u> (Hilly) (Flat) (Level)	<u>white coarse sand</u>	<u>18</u>	
(4) Purpose of Well: <u>Domestic</u> (Domestic Irrigation Municipal, Industrial, Other)	<u>4370</u>		
Information upon completion of well:			
(1) Diameter <u>2</u> inches.			
(2) Total Depth <u>116</u> feet.			
(3) Water Level <u>72</u> feet below top of ground.			
(4) Cased to <u>106</u> , Size <u>2"</u>			
(5) Screen: Size <u>1 1/4</u> , Length <u>5 ft</u>			
(6) Were any formations sealed against pollution?			
_____ yes, _____ no.			
If YES depth of formation _____			
Why _____			
Drillers Remarks: <u>250 gal per hr.</u>			

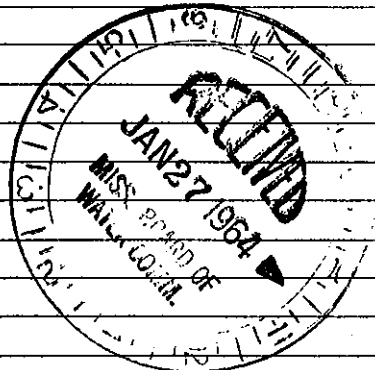

Well No.

(Use Back Side)

Retain this copy for your office files.