

LEAKE MISSISSIPPI BOARD OF WATER COMMISSIONERS

G14

7-5-63

WATER WELL DRILLERS LOG

CODED

Date: 7-5, 1963, Driller: J P Thornton County: Leake  
(Name)

(1) Owner of Land: <u>Ho Donald</u> (Name)	Description & Color of Materials Sand, Clay, Red Clay, Shell, etc.	Thick- ness Feet	Depth Feet
<u>Carthage miss</u> (Address) <u>26 11 8</u>	<u>red clay</u>	<u>35'</u>	
(2) Location: 1/4, 1/4, Sec. T R. <u>4 miles South</u> of <u>Carthage</u> (distance) (direction) (Nearest Town)	<u>white chert</u>	<u>12</u>	<u>47</u>
(3) Topography: <u>Hilly</u> (Hilly) (Flat) (Level)	<u>Yellow Sand</u>	<u>25'</u>	<u>72</u>
(4) Purpose of Well: <u>Domestic</u> (Domestic Irrigation Municipal, Industrial, Other)	<u>White sand</u>	<u>12</u>	<u>84</u>

1306


Information upon completion of well:

- (1) Diameter: 2 inches.
- (2) Total Depth: 84 feet.
- (3) Water Level: 50 feet below top of ground.
- (4) Cased to: 78, Size: 2"
- (5) Screen: Size 1 1/4, Length 6 ft.
- (6) Were any formations sealed against pollution?  
\_\_\_\_ yes, \_\_\_\_ no.

If YES depth of formation \_\_\_\_\_

Why \_\_\_\_\_

Drillers Remarks: 390 gal per hr

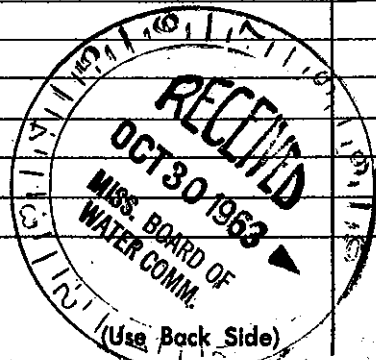

Well No. \_\_\_\_\_

Mail this copy to Board of Water Commissioners 429 Miss. St. Jackson, Miss.