

LEAKE MISSISSIPPI BOARD OF WATER COMMISSIONERS

G 15
5-18-63

WATER WELL DRILLERS LOG

CODED

Date: 5-18, 1963, Driller: J P Thornton County Leake
(Name)

(1) Owner of Land: <u>Die Green</u> (Name)	Description & Color of Materials Sand, Clay, Red Clay, Shell, etc.	Thick- ness Feet	Depth Feet
<u>Carthage</u> (Address)	<u>Yellow clay</u>	<u>40</u>	
(2) Location: <u>1/4, 16 1/4, Sec 8, T. R.</u>	<u>fine sand</u>	<u>4</u>	
<u>4</u> miles <u>East</u> of <u>Carthage</u>	<u>rock shell</u>	<u>2</u>	
(distance) (direction) (Nearest Town)	<u>Black dirt</u>	<u>46</u>	
(3) Topography: <u>hilly</u>	<u>fine Black sand</u>	<u>20</u>	
(Hilly) (Flat) (Level)	<u>Shell + sand</u>	<u>30</u>	
(4) Purpose of Well: <u>Domestic</u>	<u>Rock</u>	<u>4</u>	
(Domestic Irrigation Municipal, Industrial, Other)	<u>Gray water sand</u>	<u>30</u>	
		<u>176</u>	


Information upon completion of well:

- (1) Diameter 2 inches.
- (2) Total Depth 176 feet.
- (3) Water Level 85' feet below top of ground.
- (4) Cased to 168, Size _____
- (5) Screen: Size 1 1/4, Length 6 ft.
- (6) Were any formations sealed against pollution?
_____ yes, _____ no.

If YES depth of formation _____

Why _____

Drillers Remarks: 310 gal per hr

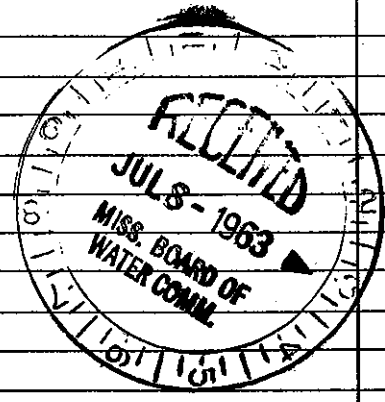

(Use Back Side)

Well No.

Mail this copy to Board of Water Commissioners 429 Miss. St. Jackson, Miss.