

Leake  
 621  
 8-68

CODED

MISSISSIPPI  
 BOARD OF WATER COMMISSIONERS  
 416 North State Street  
 Jackson, Mississippi 39201

WATER WELL DRILLERS LOG

8-17-68 19 W. S. J. Dillman Leake  
 date well completed firm name county well located


LANDOWNER	description of formations encountered	from	to
<u>Wright Water</u>			
<u>Post 2 - Carthage Miss</u> (mailing address)	<u>Red sand</u> <u>Light sand Bed</u> <u>White sand</u>	<u>0</u> <u>1</u> <u>30</u>	<u>10</u> <u>30</u> <u>68</u>

WELL LOCATION:  
 sec. 8 T. 11 N. R. 8 E. East  
6 miles South of Carthage  
 (distance) (direction) (nearest town)

WELL PURPOSE: Home  
 (home, irrigation, municipal, industrial)

- WELL COMPLETION DATA:
- (1) diameter (inches) 3 1/2
  - (2) total depth (feet) 68
  - (3) static water level (feet) 36 below top of ground.
  - (4) casing 2" 63 ft  
 (material) (depth)
  - (size) If telescope see back.
  - (5) screen 1 1/2 x 8 68  
 (length) (depth to top)
  - 2" Galvanized  
 (size) (material)
  - (6) pump 1/2 100  
 (HP) (yield gpm)
  - Electric  
 (type power)
  - (7) electric log No  
 (yes or no)
  - (organization running log)
  - (8) how well bottom plugged Super plug

CODED

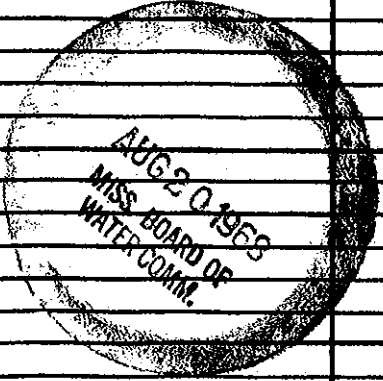

DRILLERS REMARKS: