

County: Leake
 Permit #: _____
 Driller: Thomas Drilling
 Date drilling completed: 8-16-04

Well Driller Report and Well Log

Mississippi Department of Environmental Quality
 Office of Land and Water Resources
 P.O. Box 10631
 Jackson, MS 39289-0631
 (601)961-5210
 (601)354-6938 (fax)

For Office Use Only:
 Aquifer: _____
 Well #: G-54
 L. S. Elevation: _____
 E-log #: _____

State Law requires that this report be prepared by the driller in detail and filed with the Department within 30 days of completion of drilling of the well.

Well Owner Information		Well Location	
Owner Name: <u>Jason Wade (3)</u>		Latitude: <u>N 32° 45.936' 56"</u>	Longitude: <u>W 089° 30.248' 15"</u>
Mailing Address: <u>393 Stewart Rd</u>		Method of Lat/Long (circle one): Conventional Survey, _____	
		USGS quad, <u>Hand-held</u> GPS, Survey-grade GPS	
<u>Carthage</u> MS <u>39051</u>		NW 1/4 NW 1/4 Sec <u>32</u> Twn <u>11N</u> Rng <u>8E</u>	
City State Zip Code		Distance <u>1/2</u> Miles Direction <u>NE</u> of Nearest Town <u>Carthage</u>	
Telephone No. <u>(601)</u>			

Well Data

Purpose of Well (circle one) Home Industrial Public Supply Irrigation Fish Culture Other: Poultry

Date well drilling started: 8-16-04 Date well drilling completed: 8-16-04

If flowing, method of flow regulation: Valve _____ Other (describe) _____

Static Water Level: 82' feet above or below (circle one) land surface Date measured: 8-16-04

Method of Measurement (circle one) steel tape electric tape air line other: _____

Hole depth: 145' Well depth: 145' Well grouted to a depth of 10 feet

Type of grout (circle one): Cement Bentonite Mix

Casing length: 125' feet Casing diameter: 4" inches Type of casing: PVC

Screen length: 10' feet Screen diameter: 4" inches Type of screen: PVC SAND

Screen slot size: .010 inches Setting depth: From 135 feet to 145 feet

Type of completion (circle all applicable): Gravel packed Underreamed Telescoped Open hole Natural Development

Other (describe): _____

Top of lap pipe or reduction in casing: _____ feet. **If telescoped or more than one screen, describe on back of page**

Logs run (circle all applicable): No log run Electric Gamma Ray Density Sonic Neutron Other: _____

Name of organization running log(s): _____

RECEIVED
 SEP 14 2004
 BY OLWR

I certify that the well was drilled, constructed, and completed in accordance with all applicable requirements of the Mississippi Department of Environmental Quality and/or the Mississippi Department of Health regulations and state laws.

David S. Thomas 0-147 _____
 Print Name of Water Well Contractor and License No. Signature of Water Well Contractor

If well telescopes please sketch below and show depths.

Ground Level

G-54


Description of Formations Encountered

From To

Mixed CLAY	0	37
Mixed Clay w/ fine SAND	37	70
fine SAND	70	87
Clay	87	92
Med. White SAND	92	145

If more than one screen, show location of each on sketch

Sketch the property layout and include the following: 1) the well location; 2) any permanent structures on the property that may aid in locating the well; 3) any roads, power lines, or other items that may aid in locating the property and the well; 4) indicate direction.

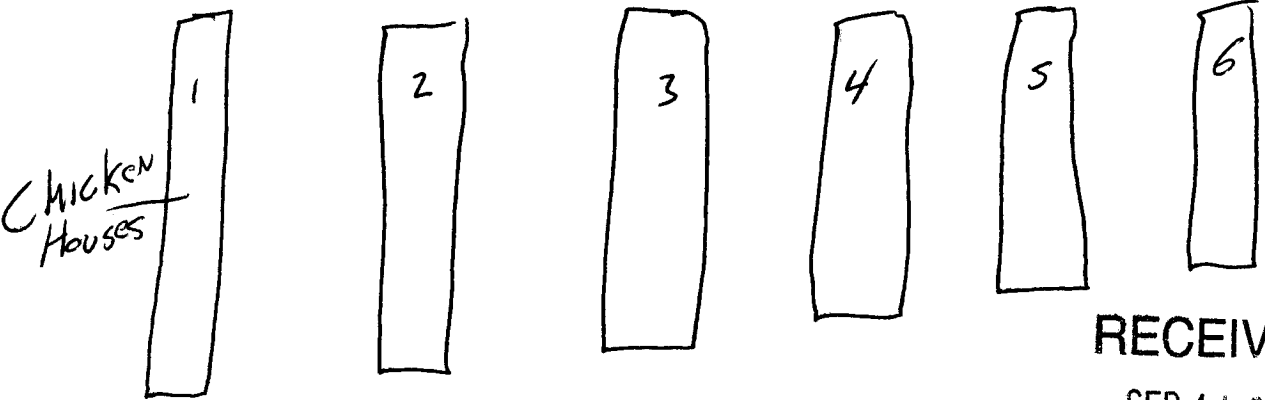

RECEIVED
SEP 14 2004
BY: OLWH

Landowner Name: JASON WARD


Signature of Water Well Contractor

STATE WELL REPORT

Part 2

Pump Installer's Completion Report

County: Leake
 Permit #: _____
 Driller: Thomas Drilling
 Date completed: 8-21-04

Mississippi Department of Environmental Quality
 Office of Land and Water Resources
 P.O. Box 10631
 Jackson, MS 39289-0631
 (601)961-5210
 (601)354-6938 (fax)

For Office Use Only:

Aquifer: _____
 Well #: G-54
 Elevation: _____

This report must be prepared by the pump installer in detail and filed with the Department within 30 days of the installation of pump. A copy of Part 1 of this report must be attached to this report.

<p align="center">Well Owner Information</p> <p>Owner Name: <u>Jason Wade (B)</u> Mailing Address: <u>393 Stewart Rd</u> <u>Carthage MS 39051</u> City State Zip Code Telephone No. <u>(601)</u></p>	<p align="center">Well Location</p> <p><u>N32°45.936' W089°30.248'</u> Latitude: _____ Longitude: _____ Method of Lat/Long (circle one): Conventional Survey, USGS quad, <u>Hand-held</u> GPS, Survey-grade GPS <u>NW ¼ NW ¼ Sec 32 Twn 11 N Rng 8 E</u> Distance Direction Nearest Town <u>1/2</u> Miles <u>NE</u> of <u>Carthage</u></p>
---	---

<p align="center">Pump Type Circle one</p> <p>Air Lift Jet <u>Submersible</u> Bucket Piston Turbine Centrifugal Rotary Flowing Well Other (specify): _____ Date Pump Installed: <u>8-21-04</u> Rated Pump Capacity: <u>19</u> Gallons Per Minute</p>	<p align="center">Power Type Circle one</p> <p>Diesel Engine Gasoline Engine Natural Gas <u>Electric Motor</u> Hand Tractor PTO Windmill Other (specify): _____ Horse Power Rating of Motor: <u>1 1/2</u> Setting Depth: <u>120'</u> Number of Stages: <u>12</u></p>
--	--

RECEIVED
 SEP 14 2004

<p align="center">Pump Test Data</p> <p>Date Well Tested: <u>8-21-04</u> Static Water Level (A): <u>82'</u> Feet Below Land Surface Pumping Water Level (B): <u>95'</u> Feet Below Land Surface Drawdown [(B) - (A)]: <u>13'</u> Feet Below Land Surface Test Pumping Rate: <u>26</u> Gallons Per Minute Duration of Pump Test (minimum 4 hours): <u>1/2</u> hours</p>	<p align="center">Method of Measuring Water Level Circle one</p> <p><u>Air Line</u> Electric Measuring Line Steel Tape Other (specify): _____ For flowing well, measured shut in head: _____ feet Well yielded _____ GPM with a drawdown of _____ feet after _____ hours of pumping</p>
--	---

BY: OLWR

I HEREBY CERTIFY that the above statements are true to the best of my knowledge.

David S. Thomas 0-147 _____
 Print Name of Pump Installer and License No. (if applicable) Signature of Pump Installer