

MISSISSIPPI DEPARTMENT OF NATURAL RESOURCES

Bureau of Land and Water Resources

Southport Mall

P.O. Box 10631

Jackson, Mississippi 39209

WATER WELL DRILLERS LOG

LEAKE
G
2017


8-18-1946 F.D. Connor LEAKE
 date well completed firm name county well located

LANDOWNER: Collon,
Jenkins
 (mailing address)

description of formations encountered	from	to
Red clay	0	19
finagel sand	19	42
Red sand	42	63

WELL LOCATION:
 sec. 30011 N R 8 E
1 miles N of Coutchog
 (distance) (direction) (nearest town)

WELL PURPOSE:
 home irrigation, municipal, industrial

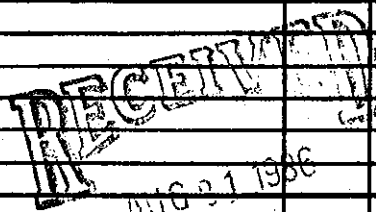

Department of Natural Resources
 Bureau of Land & Water Resources

WELL COMPLETION DATA:

(1) diameter (inches) 2"

(2) total depth (feet) 63'

(3) static water level (feet) 19' below top of ground.

(4) casing 2" 63'
 (material) (depth)
2" if telescope see back.
 (size)

(5) screen 2" 63'
 (length) (depth to top)
2x10' P.V.C.
 (size) (material)

(6) pump 1 220
 (HP) (yield gpm)
Elec.
 (type power)

(7) electric log NO
 (yes or no)
Jack Shark
 (organization running log)

(8) how well bottom plugged _____

DRILLERS REMARKS: