

H 7

CODED
H 201

WATER WELL DRILLERS LOG

7-26-60

Date: 7-26, 1960, Driller: J.P. Thornton County Leake
(Name)

(1) Owner of Land:	Description & Color of Materials Sand, Clay, Red Clay, Shell, etc.	Thick- ness Feet	Depth Feet
Charles K. Smith (Name)	Clay		22
Carthage Miss Route 8 (Address)	Dry sand		35
	Chalk + sand		15
(2) Location: 1/4, 1/4, Sec. 21 T11R9	Real fine sand		10
8 miles East of Carthage (distance) (direction) (Nearest Town)	Pm 1/2 water sand		10
(3) Topography: Kelly (Hilly) (Flat) (Level)	Blue chalk		3
(4) Purpose of Well: Domestic house hold (Domestic Irrigation Municipal, Industrial, Other)	Grey water sand		16


Information upon completion of well:

- (1) Diameter 2" inches.
- (2) Total Depth 111 feet.
- (3) Water Level 5' 5" feet below top of ground.
- (4) Cased to 105', Size 2"
- (5) Screen: Size 1/4 60#, Length 6 ft.
- (6) Were any formations sealed against pollution?
yes, no.

If YES depth of formation _____

Why _____

Drillers Remarks: 350 gallon per hour

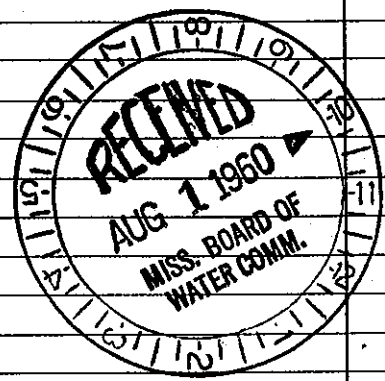

Well No. 3

(Use Back Side)