

LEAKE MISSISSIPPI BOARD OF WATER COMMISSIONERS

H 8

WATER WELL DRILLERS LOG

H 008

8-24-60

Date: 8-24, 1960, Driller: J P Shannon County Leake

(Name)

(1) Owner of Land: <u>Bew. York Cross</u>	Description & Color of Materials Sand, Clay, Red Clay, Shell, etc.	Thick- ness Feet	Depth Feet
(Name)	Clay red	28	
<u>Route 8 Carthage miss</u>	shell Rock + Clay	8	
(Address)	sand + Clay	5	
(2) Location: <u>1/4, 1/4, Sec 22 T11 R9</u>	White sand	17	
<u>8</u> miles <u>E</u> of <u>Carthage</u>			
(distance) (direction) (Nearest Town)			
(3) Topography: <u>Level</u>			
(Hilly) (Flat) (Level)			
(4) Purpose of Well: <u>Domestic</u>			
(Domestic Irrigation Municipal, Industrial, Other)			


Information upon completion of well:

- (1) Diameter 2 inches.
- (2) Total Depth 58 feet.
- (3) Water Level 30 feet below top of ground.
- (4) Cased to 53, Size 2"
- (5) Screen: Size 1 1/4 80 gweel, Length 5' 2"
- (6) Were any formations sealed against pollution?
X no.

If YES depth of formation _____

Why _____

Drillers Remarks: 3 96 gallon Per hour

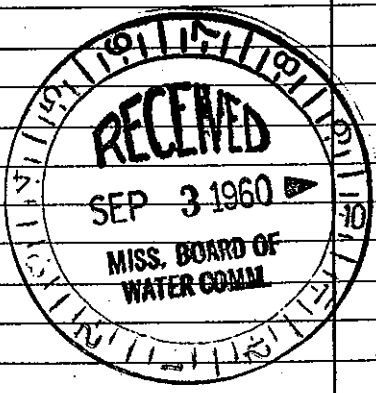

Well No.

(Use Back Side)

copy to Board of Water Commissioners 429 Miss. St. Jackson, Miss.