

LEAKE
H 9

WATER WELL DRILLERS LOG

Date: 9-23, 1960, Driller: J P Thornton County Leflore
(Name)

(1) Owner of Land: J. D. Huce
(Name)
Cartilage miss
(Address)

(2) Location: 1/4, 1/4, Sec. 11 T11R9,
1 miles North, of Edinburg
(distance) (direction) (Nearest Town)

(3) Topography: Hilly
(Hilly) (Flat) (Level)

(4) Purpose of Well: Domestic
(Domestic Irrigation, Municipal, Industrial, Other)

Description & Color of Materials Sand, Clay, Red Clay, Shell, etc.	Thick- ness Feet	Depth Feet
red clay	40	ft
rock + white chert	8	ft
Black sand	40	ft
Rock	3	ft
fine sand	15	ft
Blue Chalk	20	ft
gray sand	17	ft

Information upon completion of well:

(1) Diameter 2 inches.

(2) Total Depth 143 feet.

(3) Water Level 60 feet below top of ground.

(4) Cased to 133, Size 2"


(5) Screen: Size 1 1/4, Length 6 ft

(6) Were any formations sealed against pollution?
_____ yes, _____ no.

If YES depth of formation _____

Why _____

Drillers Remarks: 390 gal per hour

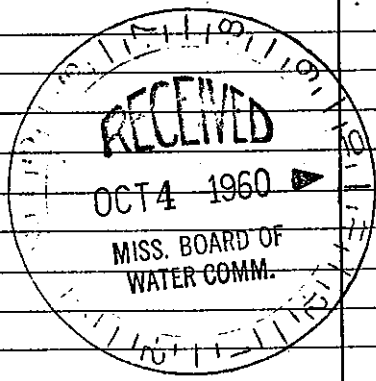

(Use Back Side)

Well No.