

**LEAKE** MISSISSIPPI BOARD OF WATER COMMISSIONERS

**H 10**

**WATER WELL DRILLERS LOG**

CODED

**3-9-62**

Date: Mar 9, 1962, Driller: Roy Wilkerson County \_\_\_\_\_  
(Name)

(1) Owner of Land:	Description & Color of Materials Sand, Clay, Red Clay, Shell, etc.	Thick- ness Feet	Depth Feet
<u>Elgie Smith</u> <small>(Name)</small>	<u>Red Sand</u>	<u>40</u>	
<u>Catherine Miss</u> <small>(Address)</small>	<u>Black Sand</u>	<u>50</u>	
(2) Location: <u>SW 1/4, N 2 1/4, Sec. 19 T11 R95</u>	<u>Blue mud &amp; Shell</u>	<u>32</u>	
<u>12</u> miles <u>E</u> of <u>Cothage</u> <small>(distance) (direction) (Nearest Town)</small>	<u>Water Sand</u>	<u>30</u>	
(3) Topography: <u>Hilly</u> <small>(Hilly) (Flat) (Level)</small>			
(4) Purpose of Well: <u>Domestic</u> <small>(Domestic Irrigation Municipal, Industrial, Other)</small>			


Information upon completion of well:

- (1) Diameter 2 inches.
- (2) Total Depth 152 feet.
- (3) Water Level 60 feet below top of ground.
- (4) Cased to 152', Size 2"
- (5) Screen: Size 2", Length 4"
- (6) Were any formations sealed against pollution?  
 yes,  no.

If YES depth of formation \_\_\_\_\_

Why \_\_\_\_\_

Drillers Remarks: \_\_\_\_\_

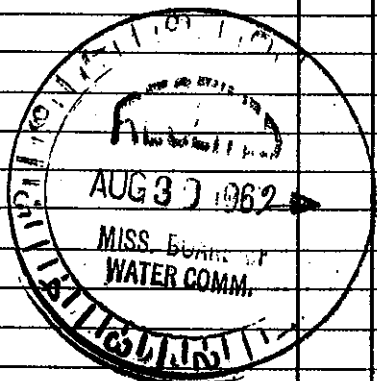

Well No.

(Use Back Side)

Mail this copy to Board of Water Commissioners 429 Miss. St. Jackson, Miss.