

LEAKE

MISSISSIPPI BOARD OF WATER COMMISSIONERS

H13

WATER WELL DRILLERS LOG

CODED

9-6-62

Date: 9-6, 1962, Driller: Sharon Drillers Co. Leake

(Name)

(1) Owner of Land: <u>Mrs. Leis Moore</u> (Name)	Description & Color of Materials Sand, Clay, Red Clay, Shell, etc.	Thick- ness Feet	Depth Feet
<u>Cartage mis</u> (Address)	<u>Hard Clay shale</u>	<u>25</u>	<u>25</u>
(2) Location: <u>1/4, 1/4, Sec. 11.9</u> T R	<u>Very fine sand</u>	<u>15</u>	<u>40</u>
<u>3</u> miles <u>W</u> of <u>Edinburg</u> (distance) (direction) (Nearest Town)	<u>Sand</u>	<u>16</u>	<u>56</u>
(3) Topography: <input checked="" type="checkbox"/> (Level) (Hilly) (Flat)			
(4) Purpose of Well: <u>Domestic</u> (Domestic Irrigation Municipal, Industrial, Other)			


Information upon completion of well:

- (1) Diameter 2 inches.
- (2) Total Depth 56 feet.
- (3) Water Level 3 1/2 feet below top of ground.
- (4) Cased to _____, Size _____.
- (5) Screen: Size 1/4, Length 4
Gal S, Steel
- (6) Were any formations sealed against pollution?
_____ yes, _____ no.

If YES depth of formation _____

Why _____

Drillers Remarks: _____

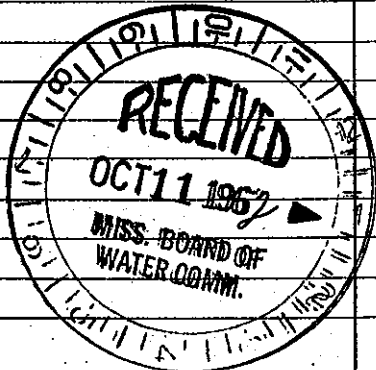

(Use Back Side)

Well No.