

Leake
H 15
7-66

MISSISSIPPI BOARD OF WATER COMMISSIONERS

WATER WELL DRILLERS LOG

CODED

Date: 7-25, 1966, Driller: J P Thornton
County Trade
(Name)

(1) Owner of Land: Charles Henry
(Name)
Carthage Miss RT5
(Address)

(2) Location: SW 1/4, NW 1/4, Sec. 17 T11R9,
9 miles East of Carthage
(distance) (direction) (Nearest Town)

(3) Topography: X
(Hilly) (Flat) (Level)

(4) Purpose of Well: Domestic
(Domestic Irrigation
Municipal, Industrial, Other)

Description & Color of Materials Sand, Clay, Red Clay, Shell, etc.	Thick- ness Feet	Depth Feet
Sand + fine gravel	27	
Black dirt	43	
Rock + Black dirt	20	
Black sand	4	
Rock	2	
shell + black sand	28	
light gray water sand	23	
	147	


Information upon completion of well:

- (1) Diameter 2 inches.
- (2) Total Depth 147 feet.
- (3) Water Level 9 1/2 feet below top of ground.
- (4) Cased to 141, Size 2"
- (5) Screen: Size 1/4, Length 1 1/4 x 6.
- (6) Were any formations sealed against pollution?
yes, no.

If YES depth of formation _____

Why _____

Drillers Remarks: 300 gals per hr

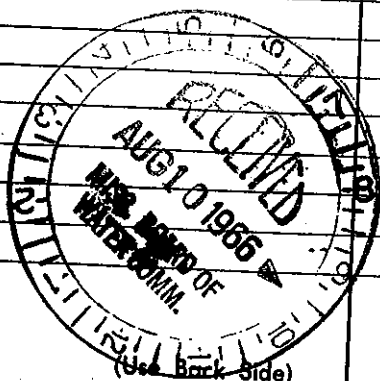

Well No. _____