

LEAKE
H 19
9-12-61

MISSISSIPPI BOARD OF WATER COMMISSIONERS CODED

H 0000 ?

WATER WELL DRILLERS LOG

Date: 9-12, 1961, Driller: J P Thornton County Leake
(Name)

M Malore

(1) Owner of Land: <u>Melore Malore</u> (Name)	Description & Color of Materials Sand, Clay, Red Clay, Shell, etc.	Thick- ness Feet	Depth Feet
<u>Carthage Miss</u> (Address)	<u>red clay</u>	<u>30</u>	
(2) Location: <u>East 1/4, 19, Sec 11 9</u> T. R.	<u>Brown sand + shell</u>		
<u>8 miles East</u> of <u>Carthage</u> (distance) (direction) (Nearest Town)	<u>Red mixed</u>	<u>20</u>	
(3) Topography: <u>Hilly</u> (Hilly) (Flat) (Level)	<u>Pink sand</u>	<u>7</u>	
(4) Purpose of Well: <u>Domestic</u> (Domestic Irrigation Municipal, Industrial, Other)	<u>White sand</u>	<u>14</u>	
<u>5191</u>			


Information upon completion of well:

- (1) Diameter 2 inches.
- (2) Total Depth 71 feet.
- (3) Water Level 45' feet below top of ground.
- (4) Cased to 63, Size 2"
- (5) Screen: Size 1 1/4, Length 6 ft.
- (6) Were any formations sealed against pollution?
 yes, no.

If YES depth of formation _____

Why _____

Drillers Remarks: 350 gal per hr.

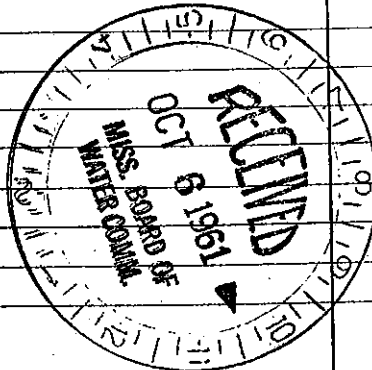

(Use Back Side)

Well No.

Mail this copy to Board of Water Commissioners 429 Miss. St. Jackson, Miss