

LEAKE MISSISSIPPI BOARD OF WATER COMMISSIONERS

CODED

H 23

WATER WELL DRILLERS LOG

4-10-63

Date: 4-10, 1963, Driller: J P Hamilton County Leake
(Name)

		Description & Color of Materials Sand, Clay, Red Clay, Shell, etc.	Thick- ness Feet	Depth Feet
(1) Owner of Land: <u>Gene Malone</u> (Name)		<u>red clay</u>	<u>27</u>	
<u>Carthage Miss</u> (Address)		<u>Rock</u>	<u>2</u>	
(2) Location: <u>1/4</u> , <u>30 11 9</u> , Sec. <u>11 9</u> , T. <u>11</u> , R. <u>9</u>		<u>fine sand</u>	<u>20</u>	
<u>8</u> miles <u>E</u> of <u>Carthage</u> (distance) (direction) (Nearest Town)		<u>Black dirt</u>	<u>25'</u>	
(3) Topography: <u>hilly</u> (Hilly) (Flat) (Level)		<u>Rock</u>	<u>6</u>	
(4) Purpose of Well: <u>Domestic</u> (Domestic Irrigation Municipal, Industrial, Other)		<u>white water sand</u>	<u>10</u>	
			<u>90</u>	

3384


Information upon completion of well:

- (1) Diameter 2 inches.
- (2) Total Depth 90 feet.
- (3) Water level 40 feet below top of ground.
- (4) Cased to 84, Size 2"
- (5) Screen: Size 1 1/4, Length 6ft
- (6) Were any formations sealed against pollution?
_____ yes, _____ no.

If YES depth of formation _____

Why _____

Drillers Remarks: 385' gal per hr

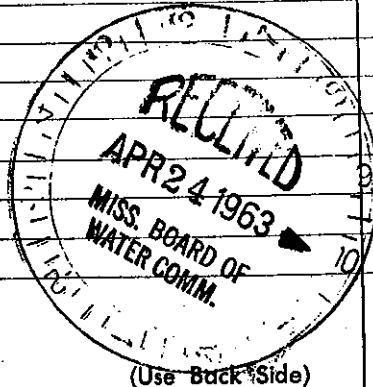

Well No.

Mail this copy to Board of Water Commissioners 429 Miss. St. Jackson, Miss.