

WELL DRILLERS LOG

CODED

Date: 11-21, 1963, Driller: J.P. Thornton

LEAKE
#25

(Name)

14-21-63 Cliff Beckham
Cartilage mine
(Name)
(Address)

Description & Color of Materials Sand, Clay, Red Clay, Shell, etc.	Thick- ness Feet	Depth Feet
Yellow clay	45'	
Black dirt	20	
Black sand	15'	
Black sand	35'	
Blue sand	18'	

(2) Location: 1/4 Sec. 11 9
8 miles E of Cartilage
(distance) (direction) (Nearest Town)

(3) Topography: Hilly
(Hilly) (Flat) (Level)

(4) Purpose of Well: Domestic
(Domestic Irrigation
Municipal, Industrial, Other)

39 34

Information upon completion of well:

(1) Diameter 2 inches.

(2) Total Depth 133 feet.

(3) Water Level 75' feet below top of ground.

(4) Cased to 120, Size 2"


(5) Screen: Size 1/4, Length 6

(6) Were any formations sealed against pollution?
yes, no.

If YES depth of formation

Why

Drillers Remarks: 325' gal per hr.

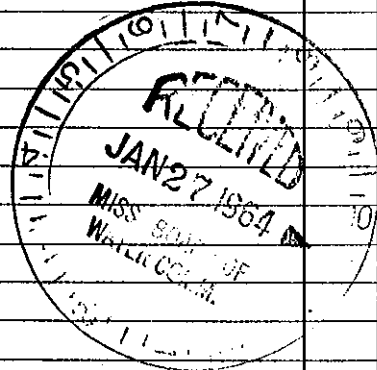

Well No.

(Use Back Side)

Retain this copy for your office files.