

LEAKE MISSISSIPPI BOARD OF WATER COMMISSIONERS

H 27

4-2-66

WATER WELL DRILLERS LOG


CODED

Date: 4-2, 1966, Driller: J P Thornton County Leake
 (Name)

(1) Owner of Land: Billy Henry
 (Name)
Carthage miss
 (Address)
 (2) Location: 1/4, 17 119 Sec. T R
9 miles E of Carthage
 (distance) (direction) (Nearest Town)
 (3) Topography: X
 (Hilly) (Flat) (Level)
 (4) Purpose of Well: Domestic
 (Domestic Irrigation Municipal, Industrial, Other)

Description & Color of Materials Sand, Clay, Red Clay, Shell, etc.	Thick- ness Feet	Depth Feet
<u>Red Clay</u>	<u>20</u>	
<u>dry sand</u>	<u>18</u>	
<u>Water sand</u>	<u>7</u>	
<u>Black dirt</u>	<u>32</u>	
<u>Peep</u>	<u>2</u>	
<u>Water sand</u>	<u>12</u>	
	<u>91</u>	

4436

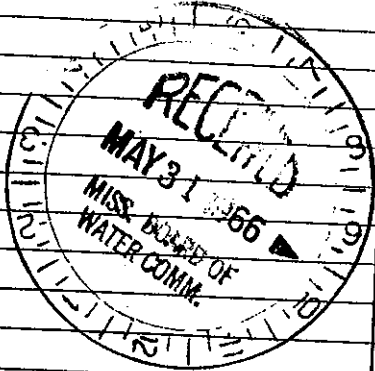

Information upon completion of well:

(1) Diameter 2 inches.
 (2) Total Depth 91 feet.
 (3) Water Level 40 feet below top of ground.
 (4) Cased to 84, Size 2
 (5) Screen: Size 1/4, Length 6 ft
 (6) Were any formations sealed against pollution?
no.

If YES depth of formation _____

Why _____

Drillers Remarks: 370 gal per hr

Well No.

(Use Back Side)

Mail this copy to Board of Water Commissioners 429 Miss. St. Jackson, Miss.