

LEAKE
H 29

WATER WELL DRILLERS LOG

CODED

Date: 10-17-61, 1961, Driller: J P Thornton County Leake

Mrs L A Hays
(Name)

(Name)

(1) Owner of Land: Mrs L A Hays

(Name)

Edinburg Miss

(Address)

(2) Location: SE 1/4, NE 1/4, Sec. 14 T11R9E

 miles
(distance)

(direction)

(Nearest Town)

(3) Topography: Hilly

(Hilly)

(Flat)

(Level)

(4) Purpose of Well: Domestic

(Domestic Irrigation
Municipal, Industrial, Other)

Description & Color of Materials
Sand, Clay, Red Clay, Shell, etc.

Thick-
ness
Feet

Depth
Feet

Red Clay
dry sand
sand + clay
white sand

21
30
4
8

21
51
55
63

1279

Information upon completion of well:

(1) Diameter 2 inches.

(2) Total Depth 63 feet.

(3) Water Level 46 feet below top of ground.

(4) Cased to 5' 9", Size 2"

(5) Screen: Size 1 1/4", Length 6 ft

(6) Were any formations sealed against pollution?


 yes, no.

If YES depth of formation

Why

Drillers Remarks: 360 gal per gallon

CODED

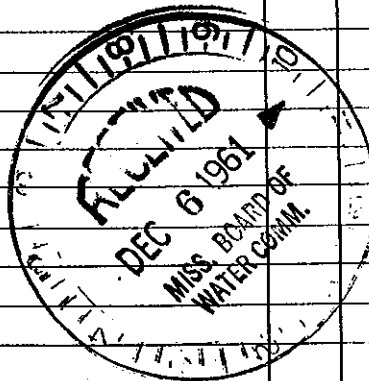

(Use Back Side)

Well No.

Retain this copy for your office files.