

LEAKE MISSISSIPPI BOARD OF WATER COMMISSIONERS

H30  
8-3-63

WATER WELL DRILLERS LOG

CODED

Date: 8-3, 1963, Driller: J.P. Thornton County Leake  
(Name)

	Description & Color of Materials Sand, Clay, Red Clay, Shell, etc.	Thick- ness Feet	Depth Feet
(1) Owner of Land: <u>V.M. Russell</u> (Name)	<u>Red Clay</u>	<u>43</u>	
<u>Edenburg</u> (Address)	<u>shel. rock</u>	<u>1</u>	
<u>11-11-9</u>	<u>fine sand</u>	<u>2.5</u>	
(2) Location: <u>1/4, 1/2 Sec 11-9</u>	<u>White water sand</u>	<u>9</u>	
_____ miles _____ of _____ (distance) (direction) (Nearest Town)			
(3) Topography: <u>Hilly</u> (Hilly) (Flat) (Level)	<u>5832</u>		
(4) Purpose of Well: <u>Domestic</u> (Domestic Irrigation Municipal, Industrial, Other)			


Information upon completion of well:

- (1) Diameter 2 inches.
- (2) Total Depth 78 feet.
- (3) Water Level 45' feet below top of ground.
- (4) Cased to 74, Size 2"
- (5) Screen: Size 1 1/4, Length 6ft
- (6) Were any formations sealed against pollution?  
\_\_\_\_\_ yes, \_\_\_\_\_ no.

If YES depth of formation \_\_\_\_\_

Why \_\_\_\_\_

Drillers Remarks: 350

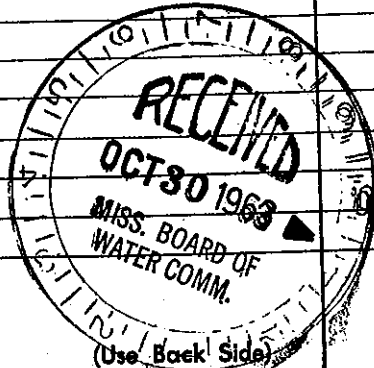

Well No.

Mail this copy to Board of Water Commissioners 429 Miss. St. Jackson, Miss.