

LEAKE

MISSISSIPPI BOARD OF WATER COMMISSIONERS

H31
7-31-61

WATER WELL DRILLERS LOG

M
CODED

Date: 7-31, 1961, Driller: J.P. Thornton County Leake
(Name)

(1) Owner of Land: <u>Billy Rushing</u> (Name)	Description & Color of Materials Sand, Clay, Red Clay, Shell, etc.	Thick- ness Feet	Depth Feet
<u>Carthage miss</u> (Address)	<u>Red Clay</u>	<u>12</u>	<u>15</u>
(2) Location: <u>1/4 Sec. 11 9</u>	<u>Brown Sand</u>	<u>50</u>	<u>65</u>
<u>Hwy 16 E</u> <u>10 miles East</u> of <u>Carthage</u> (distance) (direction) (Nearest Town)	<u>Red sand</u>	<u>70</u>	<u>135</u>
(3) Topography: <u>Hilly</u> (Hilly) (Flat) (Level)	<u>Rock sand</u>	<u>85</u>	<u>220</u>
(4) Purpose of Well: <u>Domestic</u> (Domestic Irrigation Municipal, Industrial, Other)	<u>White water sand</u>	<u>15</u>	<u>235</u>
<u>4234</u>			


Information upon completion of well:

- (1) Diameter 2 inches.
- (2) Total Depth 235' feet.
- (3) Water level 50 feet below top of ground.
- (4) Cased to 224, Size 2"
- (5) Screen: Size 70 Screen open well, Length _____
- (6) Were any formations sealed against pollution?
_____ yes, _____ X no.

If YES depth of formation _____

Why _____

Drillers Remarks: 300 gal per hour

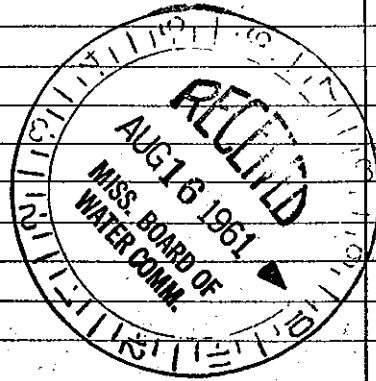

(Use Back Side)

Well No.