

LEAKE

WATER WELL DRILLERS LOG

Date: 8-22-61 ^{H 35}, Driller: J.P. Thornton County Leake
(Name)

(1) Owner of Land: J.D. Nease
(Name)
Carriage miss
(Address)

(2) Location: 1/4, 1/4, Sec. 4 ^{1199E} T R
miles 1 1/2 ^W Edinburgh
(distance) (direction) (Nearest Town)

(3) Topography: X
(Hilly) (Flat) (Level)

(4) Purpose of Well: Domestic
(Domestic Irrigation
Municipal, Industrial, Other)

Description & Color of Materials Sand, Clay, Red Clay, Shell, etc.	Thickness Feet	Depth Feet
<u>red clay</u>	<u>15</u>	
<u>blue chalk</u>	<u>6</u>	
<u>real fine sand</u>	<u>9</u>	
<u>real coarse water sand</u>	<u>19</u>	

Information upon completion of well:

(1) Diameter 2 inches.

(2) Total Depth 42 feet.

(3) Water Level _____ feet below top of ground.

(4) Cased to 37, Size 2


(5) Screen: Size 1 1/4 ^{gauge}, Length 6 ft

(6) Were any formations sealed against pollution?
_____ yes, X no.

If YES depth of formation _____

Why _____

Drillers Remarks: 400 gal per hour

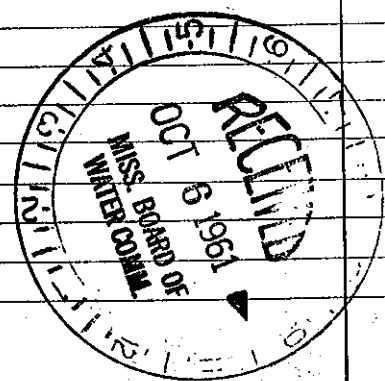

(Use Back Side)

Well No.