

MISSISSIPPI BOARD OF WATER COMMISSIONERS

LEAKE
 H 38
 11-18-63

WATER WELL DRILLERS LOG


CODED

Date: 11-18-63, 1963, Driller: J P Thornton County Leake
 (Name)

(1) Owner of Land: <u>J I Matone</u> (Name)	Description & Color of Materials Sand, Clay, Red Clay, Shell, etc.	Thick- ness Feet	Depth Feet
<u>Carthage miss</u> (Address)	<u>Red Clay</u>	<u>30</u>	
(2) Location: <u>1/4, 1 1/4 Sec. 11 9</u> T. R.	<u>Black Soil</u>	<u>30</u>	
<u>7</u> miles <u>E</u> , of <u>Carthage</u> (distance) (direction) (Nearest Town)	<u>Black sand</u>	<u>15</u>	
(3) Topography: <u>Hilly</u> (Hilly) (Flat) (Level)	<u>fine sand</u>	<u>10</u>	
(4) Purpose of Well: <u>Domestic</u> (Domestic Irrigation Municipal, Industrial, Other)	<u>Coarse Gray sand</u>	<u>28</u>	
			<u>113</u>

Information upon completion of well:

- (1) Diameter 2 inches.
- (2) Total Depth 113 feet.
- (3) Water Level 80 feet below top of ground.
- (4) Cased to 10 7, Size 2
- (5) Screen: Size 1/4, Length 6ft
- (6) Were any formations sealed against pollution?
 yes, no.

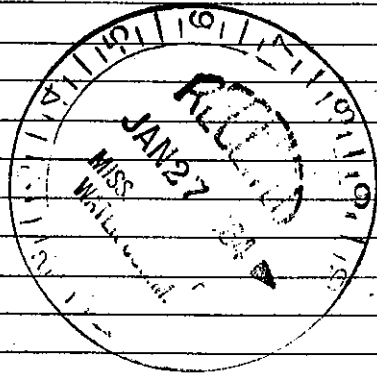

If YES depth of formation _____

Why _____

Drillers Remarks: 325' gal per hr.

Well No.

(Use Back Side)

Retain this copy for your office files.