

MISSISSIPPI DEPARTMENT OF NATURAL RESOURCES

Bureau of Land and Water Resources

Southport Mall

P.O. Box 10631

Jackson, Mississippi 39209

WATER WELL DRILLERS LOG

CODED

CODED

LEAKS
H 54

5-10-1986 F.O. Conroy Leake
 date well completed firm name county well located

LANDOWNER	Description of formations encountered	from	to
<u>Mark Beckham</u>	<u>red clay</u>	<u>0</u>	<u>20</u>
<u>Cartage #3</u>	<u>black</u>	<u>20</u>	<u>42</u>
	<u>green sand</u>	<u>42</u>	<u>47</u>
	<u>red sand</u>	<u>47</u>	<u>63</u>

WELL LOCATION:
 sec 33 11 N R 9 E
8 miles E of Cartage
 (distance) (direction) (nearest town)

WELL PURPOSE:
 (home) irrigation, municipal, industrial

WELL COMPLETION DATA:

(1) diameter (inches) 2"

(2) total depth (feet) 63'

(3) static water level (feet) 5-2' below top of ground.

(4) casing 2" 63'
 (material) (depth)

2" if telescope see back.
 (size)

(5) screen 2" 63'
 (length) (depth to top)

2x10' PVC
 (size) (material)

(6) pump 1 220
 (HP) (yield gpm)


Elec.
 (type power)

(7) electric log NO
 (yes or no)

Sand Block
 (organization running log)

(8) how well bottom plugged _____

CODED

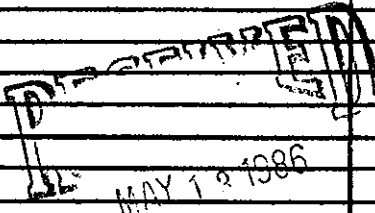

Department of Natural Resources
 Bureau of Land & Water Resources

DRILLERS REMARKS: