

J1
9-17-62

WATER WELL DRILLERS LOG

Date: 9-17, 1962, Driller: Heaven Drilling County Leake
(Name)

(1) Owner of Land: <u>Henry Leflore</u> (Name)	Description & Color of Materials Sand, Clay, Red Clay, Shell, etc.	Thick- ness Feet	Depth Feet
<u>Rt 4 Carthage</u> (Address)	<u>Red Clay</u>	<u>20</u>	<u>20</u>
(2) Location: <u>SE 1/4, NE 1/4, Sec. 5 T10R6</u>	<u>Cream Sand</u>	<u>30</u>	<u>50</u>
<u>3</u> miles <u>N</u> of <u>Stabona</u> (distance) (direction) (Nearest Town)	<u>White Sand</u>	<u>4</u>	<u>54</u>
(3) Topography: <u>Hilly</u> (Hilly) (Flat) (Level)	<u>Cream Sand</u>	<u>16</u>	<u>70</u>
(4) Purpose of Well: <u>Domestic</u> (Domestic Irrigation Municipal, Industrial, Other)	↓ <u>Black clay</u>		
Information upon completion of well:			

(1) Diameter 2 inches.

(2) Total Depth 70 feet.

(3) Water Level 49 feet below top of ground.

(4) Cased to 63, Size 2


(5) Screen: Size 1/4, Length 6

(6) Were any formations sealed against pollution?
 _____ yes, no.

If YES depth of formation _____

Why _____

Drillers Remarks: _____

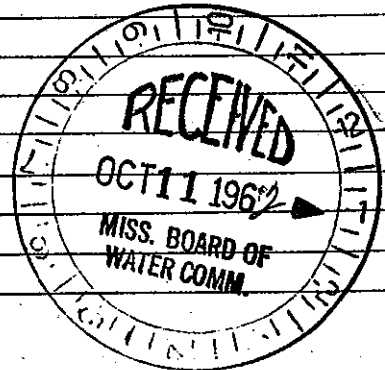

(Use Back Side)

Well No.