

LEAKE MISSISSIPPI BOARD OF WATER COMMISSIONERS

J 2
5-15-63

WATER WELL DRILLERS LOG

CODED

Date: 5-15, 1963, Driller: Heron Drilling Co County: Leake

(Name)

(1) Owner of Land: J. V. Tucker
(Name)
Cartage Miss
(Address)

(2) Location: 1/4, 1/4, Sec. 24 T. 10 R. 6
6 miles N, of Cartage
(distance) (direction) (Nearest Town)

(3) Topography: Level
(Hilly) (Flat) (Level)

(4) Purpose of Well: Domestic
(Domestic Irrigation, Municipal, Industrial, Other)

Description & Color of Materials Sand, Clay, Red Clay, Shell, etc.	Thick- ness Feet	Depth Feet
Hard Clay	15	15
Sand	10	25
Red Clay	25	50
Sand clay mix	18	68
Loam	2	70
Grey Clay	10	80
Loam	2	82
Soft shale	18	100
Loam sand & shale	90	190
Hard shale	10	200
Sand & shale	20	220
Hard shale	10	230
Loam shale & sand	20	250
Coarse white sand	22	272

Information upon completion of well:

(1) Diameter 1 inches.

(2) Total Depth 272 feet.

(3) Water Level 64 1/2 feet below top of ground.

(4) Cased to _____, Size 2


(5) Screen: Size 2 1/2 x 5', Length _____

(6) Were any formations sealed against pollution?
_____ yes, X no.

If YES depth of formation _____

Why _____

Drillers Remarks: As above

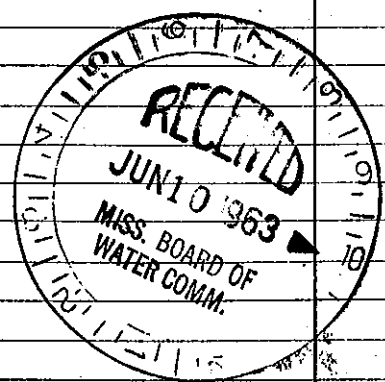

(Use Back Side)

Well No.

Mail this copy to Board of Water Commissioners 429 Miss. St. Jackson, Mis.