

LEAKE

MISSISSIPPI BOARD OF WATER COMMISSIONERS

J3

WATER WELL DRILLERS LOG

CODED

6-19-63

Date: 6-19, 1963, Driller: Hearn Drilling Co County: Leake

(Name)

(1) Owner of Land <i>Lamar Hamilton</i> (Name)	Description & Color of Materials Sand, Clay, Red Clay, Shell, etc.	Thick- ness Feet	Depth Feet
<i>Cartledge Miss</i> (Address)	<i>Hard Clay</i>	<i>15</i>	<i>15</i>
(2) Location: $\frac{23}{4}$, $\frac{10}{4}$, Sec. $\frac{6}{4}$ T R	<i>Red sand</i>	<i>10</i>	<i>25</i>
<i>7</i> miles <i>N</i> of <i>Cartledge</i> (distance) (direction) (Nearest Town)	<i>Beach dirt</i>	<i>15</i>	<i>40</i>
(3) Topography: <input checked="" type="checkbox"/> (Hilly) <input type="checkbox"/> (Flat) <input type="checkbox"/> (Level)	<i>Beach sand</i>	<i>20</i>	<i>60</i>
(4) Purpose of Well: <i>Domestic</i> (Domestic Irrigation, Municipal, Industrial, Other)	<i>Beach dirt</i>	<i>15</i>	<i>75</i>
	<i>Red</i>	<i>2</i>	<i>77</i>
	<i>Beach dirt</i>	<i>83</i>	<i>160</i>
	<i>Dark sand</i>	<i>20</i>	<i>180</i>
	<i>Gard Gray</i>	<i>60</i>	<i>240</i>
	<i>Gray sand</i>	<i>13</i>	<i>253</i>


Information upon completion of well:

- (1) Diameter 2 inches.
- (2) Total Depth 253 feet.
- (3) Water Level 69 feet below top of ground.
- (4) Cased to _____, Size _____
- (5) Screen: Size 2 1/2", Length 5'
all 5' steel
- (6) Were any formations sealed against pollution?
_____ yes, _____ no.

If YES depth of formation _____

Why _____

Drillers Remarks: *Dr Well
Fine Water and
Good Producer*

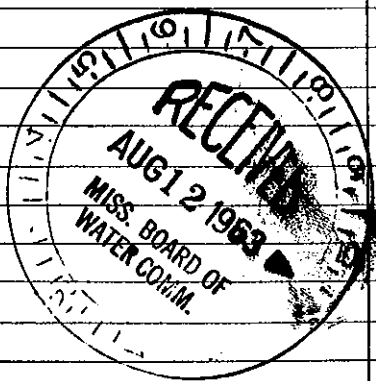

Well No.

(Use Back Side)