

LEAKE MISSISSIPPI BOARD OF WATER COMMISSIONERS

3903
CODED

J 9
3-14-61 WATER WELL DRILLERS LOG

Date 3-14, 1961, Driller: Harold Dineen Deaf County Leake
(Name)

(1) Owner of Land: <u>V.K. Tucker</u> (Name)	Description & Color of Materials Sand, Clay, Red Clay, Shell, etc.	Thick- ness Feet	Depth Feet
<u>R7D Carthage, Miss</u> (Address)	<u>Red Sand Clay</u>	<u>17</u>	<u>17</u>
(2) Location: <u>1/4, 1/4, Sec. 23</u> T R	<u>Yellow Sand</u>	<u>4</u>	<u>21</u>
<u>6 miles West of Carthage</u> miles of (direction) (Nearest Town)	<u>Black Clay</u>	<u>23</u>	<u>44</u>
(3) Topography: <u>✓</u> (Hilly) (Flat) (Level)	<u>Dark Brown Sand</u>	<u>9</u>	<u>53</u>
(4) Purpose of Well: <u>Chicken Farm</u> (Domestic Irrigation, Municipal, Industrial, Other)	<u>Beach Clay</u>	<u>4</u>	<u>57</u>
	<u>Green to Black Clay</u>	<u>12</u>	<u>69</u>
	<u>Rock</u>	<u>1</u>	<u>70</u>
	<u>Green Clay</u>	<u>70</u>	<u>140</u>
	<u>Light Grey Peppery Sand</u>	<u>15</u>	<u>155</u>

Information upon completion of well:


- (1) Diameter 2 inches.
- (2) Total Depth 155 feet.
- (3) Water Level 73 feet below top of ground.
- (4) Cased to 148, Size 2
- (5) Screen: Size 1/4, Length 6
- (6) Were any formations sealed against pollution?
_____ yes, no.

If YES depth of formation _____

Why _____

Drillers Remarks: Location not

available - Approx 2 way
Between Hwy 13 & Yockanawony Hwy
on rd Hwy 16 100 yds South of Road

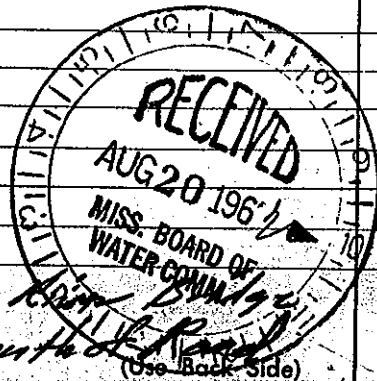

Well No _____

Send this copy to Board of Water Commissioners 429 Miss. St. Jackson, Miss.