

LEAKE MISSISSIPPI BOARD OF WATER COMMISSIONERS

K 11

7-26-62

WATER WELL DRILLERS LOG

CODED

Date: 7-26, 1962, Driller: J.P. Thornton County Leake
 (Name)

(1) Owner of Land	Description & Color of Materials Sand, Clay, Red Clay, Shell, etc.	Thick- ness Feet	Depth Feet
<u>Perrin's Culpeper</u> (Name)	<u>gray clay</u>	<u>17</u>	
<u>Carthage miss</u> (Address)	<u>red sand</u>	<u>4</u>	
(2) Location: <u>1/4</u> , <u>12</u> Sec. <u>10</u> T. <u>7</u> R.	<u>white coarse sand</u>	<u>8</u>	
<u>1</u> miles <u>W</u> of <u>Carthage</u> (distance) (direction) (Nearest Town)	<u>274-528</u>	<u>29</u>	
(3) Topography: <u>Level</u> (Hilly) (Flat) (Level)			
(4) Purpose of Well: <u>Domestic</u> (Domestic Irrigation Municipal, Industrial, Other)			


Information upon completion of well:

- (1) Diameter 2 inches.
- (2) Total Depth 29 feet.
- (3) Water Level 18 feet below top of ground.
- (4) Cased to 24, Size 2"
- (5) Screen: Size 1 1/4, Length 5'4"
- (6) Were any formations sealed against pollution?
 _____ yes, _____ no.

If YES depth of formation _____

Why _____

Drillers Remarks: 390 gal per hr

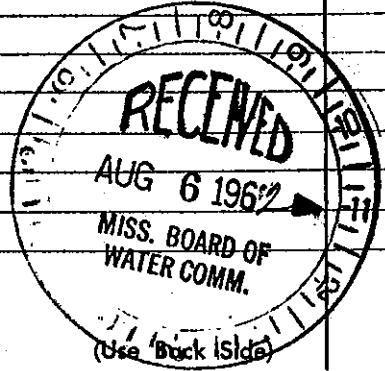

Well No. _____

Mail this copy to Board of Water Commissioners 429 Miss. St. Jackson, Mis