

LEAKE

MISSISSIPPI BOARD OF WATER COMMISSIONERS

K 12

WATER WELL DRILLERS LOG

CODED

10-12-62

Date: 10-12, 1962, Driller: J.P. Thornton County Leake

(Name)

(1) Owner of Land: <u>George Roberts</u> (Name) <u>Carthage Miss</u> (Address)	Description & Color of Materials Sand, Clay, Red Clay, Shell, etc.	Thickness Feet	Depth Feet
		19	
(2) Location: <u>1/4 Sec. 10 7</u> <u>1</u> miles <u>west</u> of <u>Carthage</u> (distance) (direction) (Nearest Town)	Red Clay	7	31
		Yellow sand	
(3) Topography: <u>Level</u> (Hilly) (Flat) (Level)	Real coarse white sand	5	31
		2491	
(4) Purpose of Well: <u>Domestic</u> (Domestic Irrigation Municipal, Industrial, Other)			


Information upon completion of well:

- (1) Diameter 2 inches.
- (2) Total Depth 31 feet.
- (3) Water Level 19 feet below top of ground.
- (4) Cased to 25', Size 1 1/4.
- (5) Screen: Size 1 1/4, Length 6ft.
- (6) Were any formations sealed against pollution?  
\_\_\_\_\_ yes, \_\_\_\_\_ no.

If YES depth of formation \_\_\_\_\_

Why \_\_\_\_\_

Drillers Remarks: 400 gal per hr.

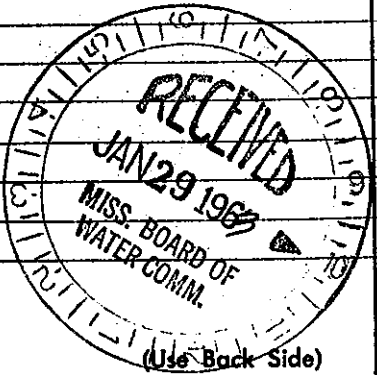

Well No.

Mail this copy to Board of Water Commissioners 429 Miss. St. Jackson, Miss