

LEAKE MISSISSIPPI BOARD OF WATER COMMISSIONERS

K14  
5-8-63

WATER WELL DRILLERS LOG

CODED

Date: 5-8, 1963, Driller: J P Hamilton County Leake  
(Name)

(1) Owner of Land:	Description & Color of Materials Sand, Clay, Red Clay, Shell, etc.	Thick- ness Feet	Depth Feet
Peepes Alford (Name) Cortage, Miss (Address)	Yellow Clay	27	
34 10-7 (Address)	Dry white fine sand	25	
(2) Location: 1/4, 1/4, Sec. T R	Black Chalk	8	
6 miles South W. of Cortage, (distance) (direction) (Nearest Town)	Rock	2	
(3) Topography: Flat (Hilly) (Flat) (Level)	Black sand	15	
(4) Purpose of Well: Domestic (Domestic Irrigation, Municipal, Industrial, Other)	sand	1	
	Red yellow sand	10	
	White Chalk	2	
	Gray water sand	21	
		106	


Information upon completion of well:

- (1) Diameter 2 inches.
- (2) Total Depth 106 feet.
- (3) Water Level 60 feet below top of ground.
- (4) Cased to 98, Size 2"
- (5) Screen: Size 2 1/4 Length 6 ft.
- (6) Were any formations sealed against pollution?  
yes,  no.

If YES depth of formation \_\_\_\_\_

Why \_\_\_\_\_

Drillers Remarks: 30 gal per hr

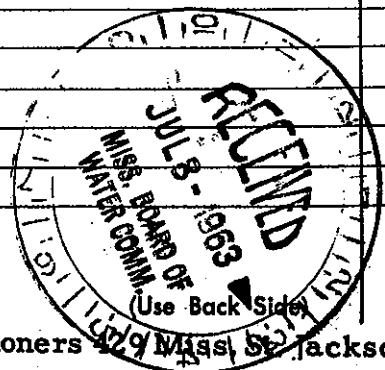

Well No.

Mail this copy to Board of Water Commissioners 479 N. Main St. Jackson, Miss.