

LEAKE MISSISSIPPI BOARD OF WATER COMMISSIONERS

~~200~~ K 17

WATER WELL DRILLERS LOG

7 CODED

3-20-61

Date: 3-20, 1961, Driller: Hearon Drilling County Leake

(Name)

- (1) Owner of Land: Peter May
(Name)
- Rt 2, Carthage
(Address)
- (2) Location: NW 1/4, NE 1/4, Sec. 20 T10R7E
(Township Range Easting)
- 2 miles NW, of Carthage
(distance) (direction) (Nearest Town)
- (3) Topography: Hilly
(Hilly) (Flat) (Level)
- (4) Purpose of Well: Domestic
(Domestic Irrigation Municipal, Industrial, Other)

Description & Color of Materials Sand, Clay, Red Clay, Shell, etc.	Thick- ness Feet	Depth Feet
Red Clay	20	20
Red-white Sand	35	55
White-yellow Sand	30	85
White-grey pebbly Sand	11 1/2	96 1/2


Information upon completion of well:

- (1) Diameter 2 inches.
- (2) Total Depth 96 1/2 feet.
- (3) Water Level 58 1/2 feet below top of ground.
- (4) Cased to 89 1/2, Size 2
- (5) Screen: Size 1/4, Length 6 ft.
- (6) Were any formations sealed against pollution?
 yes, no.

If YES depth of formation _____

Why _____

Drillers Remarks: _____

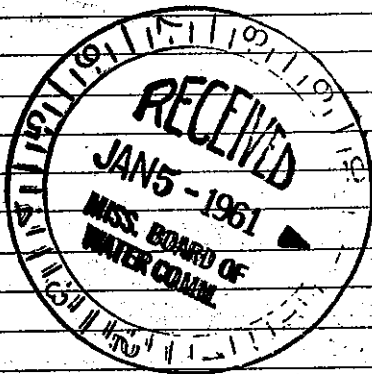

(Use Back Side)

Well No.

Mail this copy to Board of Water Commissioners 429 Miss. St. Jackson, Miss