

MISSISSIPPI BOARD OF WATER COMMISSIONERS


LEAKE
~~19~~ 19
 10-25-60

WATER WELL DRILLERS LOG

LOCATED
 11/7/60

Date: 10-25, 1960, Driller: J P Thornton County Leake
 (Name)

	Description & Color of Materials Sand, Clay, Red Clay, Shell, etc.	Thick- ness Feet	Depth Feet
(1) Owner of Land: <u>Charley Chesnut</u> (Name)	<u>red clay</u>	<u>30</u>	
<u>Carthage miss</u> (Address)	<u>dry sand</u>	<u>35</u>	<u>65</u>
(2) Location: <u>1/4, 1/4, Sec. 10 T. 0. R. 7E</u>	<u>White clay + sand</u>	<u>30</u>	<u>95</u>
<u>1 1/2</u> miles <u>W</u> , of <u>Carthage</u> (distance) (direction) (Nearest Town)	<u>real fine sand</u>	<u>10</u>	<u>105</u>
(3) Topography: <u>hilly</u> (Hilly) (Flat) (Level)	<u>White water sand</u>	<u>14</u>	<u>119</u>
(4) Purpose of Well: <u>Domestic</u> (Domestic Irrigation Municipal, Industrial, Other)			
Information upon completion of well:			
(1) Diameter <u>2</u> inches.			
(2) Total Depth <u>119</u> feet.			
(3) Water Level <u>65</u> feet below top of ground.			
(4) Cased to <u>111</u> , Size <u>2"</u>			
(5) Screen: Size <u>1/4</u> , Length <u>6 ft</u>			
(6) Were any formations sealed against pollution? _____ yes, _____ no.			
If YES depth of formation _____			
Why _____			
Drillers Remarks: <u>325' gallon per hour</u>			

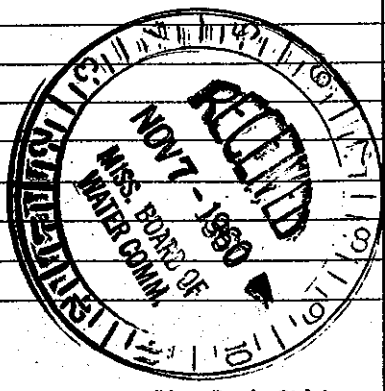

Well No.

Mail this copy to Board of Water Commissioners 429 Miss. St. Jackson, Miss.