

LEAKE MISSISSIPPI BOARD OF WATER COMMISSIONERS

K24

WATER WELL DRILLERS LOG

CODED

8-8-60

Date: 8-8, 1960, Driller: Heaton Drilling County Leake

(Name)

(1) Owner of Land: Frazier Carter
Box 254
Rt 2 Carthage

(2) Location: 2 10 7
1/4, 1/4, Sec. T R

1 miles NW of Carthage
(distance) (direction) (Nearest Town)

(3) Topography: Hilly
(Hilly) (Flat) (Level)

(4) Purpose of Well: Domestic
(Domestic Irrigation
Municipal, Industrial, Other)

Description & Color of Materials Sand, Clay, Red Clay, Shell, etc.	Thick- ness Feet	Depth Feet
Red clay	22	22
fine W. sand & soap stone	67	89
Black clay	6	95
Grey (light) sand	4	97
Tan - Brown Sand	15+	112
3560		


Information upon completion of well:

- (1) Diameter: 2 inches.
- (2) Total Depth: 112 feet.
- (3) Water Level: 31 feet below top of ground.
- (4) Cased to: 104, Size: 2
- (5) Screen: Size: 800 mesh, Length: 6'
- (6) Were any formations sealed against pollution?
yes, no.

If YES depth of formation

Why

Drillers Remarks:

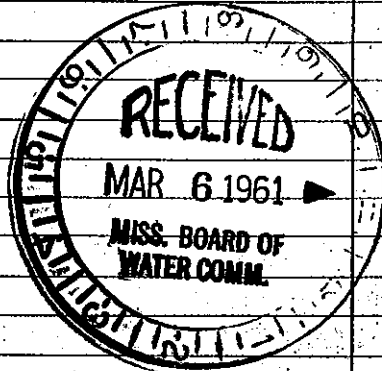

(Use Back Side)

Well No.