

LEAKE
L 13

MISSISSIPPI BOARD OF WATER COMMISSIONERS

11-27-62

WATER WELL DRILLERS LOG

CODED

Date: 11-27, 1962, Driller: Hearon County Leake
(Name)

(1) Owner of Land: RJR Farms
(Name)
Carthage Miss
(Address)

(2) Location: 1/4, 1/4, Sec. 31 T10R8,
6 miles SSW of Carthage
(distance) (direction) (Nearest Town)

(3) Topography: Hilly
(Hilly) (Flat) (Level)

(4) Purpose of Well: Domestic
(Domestic Irrigation
Municipal, Industrial, Other)

Description & Color of Materials Sand, Clay, Red Clay, Shell, etc.	Thick- ness Feet	Depth Feet
<u>Red clay</u>		<u>10</u>
<u>yellow clay</u>		<u>1528</u>
<u>white pebbly sand</u>		<u>218 246</u>
<u>Dark gray shale</u>		<u>80 326</u>
<u>Rock</u>		<u>4 330</u>
<u>Soft lime Green</u>		<u>28 358</u>
<u>Rock</u>		<u>2 360</u>
<u>Soft Green Limestone</u>		<u>37 397</u>
<u>Rock</u>		<u>507</u>

Information upon completion of well:

(1) Diameter 2 inches.

(2) Total Depth 500 feet.

(3) Water Level 81 feet below top of ground.

(4) Cased to 329, Size None


(5) Screen: Size None Length —

(6) Were any formations sealed against pollution?
— yes, X no.

If YES depth of formation _____

Why _____

Drillers Remarks: _____

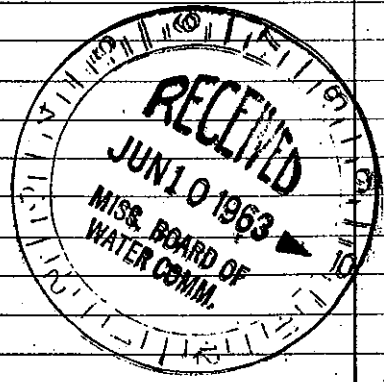

(Use Back Side)

Well No.

Mail this copy to Board of Water Commissioners 429 Miss. St. Jackson, Miss