

L 17

CODED
L 300

WATER WELL DRILLERS LOG

Date: 7-30-60, 1960, Driller: _____ County: Leake

(Name)


(1) Owner of Land: LH Collier
(Name)
Carthage miss
(Address)

(2) Location: 1/4, 1/4, Sec. 22 T10R8,
7 miles South E of Carthage
(distance) (direction) (Nearest Town)

(3) Topography: hilly
(Hilly) (Flat) (Level)

(4) Purpose of Well: Domestic house use
(Domestic Irrigation, Municipal, Industrial, Other)

Description & Color of Materials Sand, Clay, Red Clay, Shell, etc.	Thick- ness Feet	Depth Feet
<u>white chalk</u>		<u>25</u>
<u>Sand & chalk mixed</u>		<u>20 45</u>
<u>white water sand</u>		<u>19 64</u>

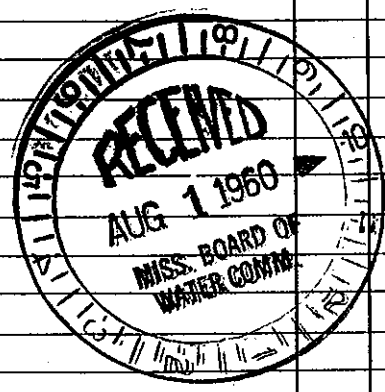

Information upon completion of well:

(1) Diameter: 2 inches.

(2) Total Depth: 64 feet.

(3) Water Level: 35' feet below top of ground.

(4) Cased to: 5'8, Size 2"

(5) Screen: Size 1 1/4 60#, Length 6 ft

(6) Were any formations sealed against pollution?
_____ yes, _____ X no.

If YES depth of formation _____

Why _____

Drillers Remarks: 300 gal/hr

Well No. _____

(Use Back Side)