

LEAKE MISSISSIPPI BOARD OF WATER COMMISSIONERS

L19

CODED

1-20-64

WATER WELL DRILLERS LOG

Date: 1-20, 1964, Driller: J P Thornton County Leake

(Name)

(1) Owner of Land:	Description & Color of Materials Sand, Clay, Red Clay, Shell, etc.	Thick- ness Feet	Depth Feet
<u>J B Hogue</u> (Name)	<u>red clay</u>	<u>21</u>	
<u>Carthage Miss</u> (Address)	<u>yellow sand</u>	<u>6</u>	
(2) Location: $\frac{1}{4}$, <u>S</u> $\frac{1}{4}$, Sec. <u>10</u> <u>8</u> T. R.	<u>white water sand</u>	<u>9</u>	
<u>1</u> miles <u>E</u> of <u>Carthage</u> (distance) (direction) (Nearest Town)		<u>36</u>	
(3) Topography: <u>level</u> (Hilly) (Flat) (Level)			
(4) Purpose of Well: <u>Domestic</u> (Domestic Irrigation Municipal, Industrial, Other)	<u>1882</u>		

Information upon completion of well:

(1) Diameter 2 inches.

(2) Total Depth 36 feet.

(3) Water Level 22 feet below top of ground.

(4) Cased to 30, Size 2"


(5) Screen: Size 1 1/4, Length 6

(6) Were any formations sealed against pollution?
 yes, no.

If YES depth of formation _____

Why _____

Drillers Remarks: 390 gal Per hr

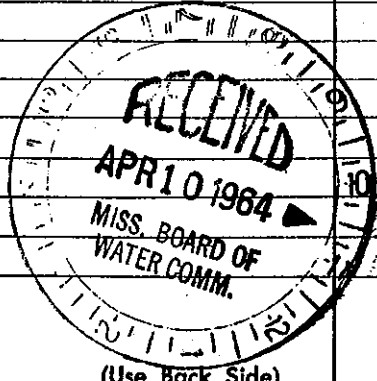

Well No.