

LEAKE MISSISSIPPI BOARD OF WATER COMMISSIONERS


L 21
10-20-62

WATER WELL DRILLERS LOG

CODED

Date: 10-20, 1962 Driller: J. P. Thornton County Leake
(Name)

(1) Owner of Land: <u>OH Donald</u> (Name)	Description & Color of Materials Sand, Clay, Red Clay, Shell, etc.	Thick- ness Feet	Depth Feet
<u>Carthage</u>	<u>red clay</u>	<u>25</u>	
(Address) <u>HWY 35 S</u>	<u>gy sand</u>	<u>30</u>	
(2) Location: <u>1/4 Sec 10 T 8</u>	<u>Blue Chalk</u>	<u>4</u>	
<u>3 miles South</u> of <u>Carthage</u> (distance) (direction) (Nearest Town)	<u>white coarse sand</u>	<u>11</u>	
(3) Topography: <u>hilly</u> (Hilly) (Flat) (Level)			
(4) Purpose of Well: <u>Domestic</u> (Domestic Irrigation Municipal, Industrial, Other)			
Information upon completion of well:			
(1) Diameter <u>2</u> inches.			
(2) Total Depth <u>70</u> feet.			
(3) Water Level <u>50</u> feet below top of ground.			
(4) Cased to <u>63</u> , Size <u>2"</u>			
(5) Screen: Size <u>1 1/4</u> , Length <u>6 ft</u>			
(6) Were any formations sealed against pollution? <u>no</u>			
If YES depth of formation _____			
Why _____			
Drillers Remarks: <u>390 gal per hr</u>			

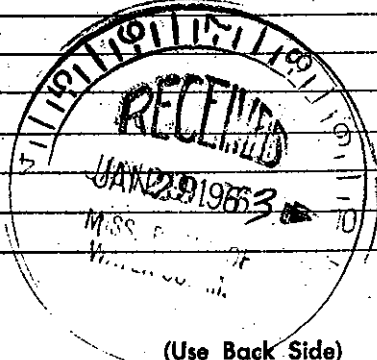

(Use Back Side)

Well No.

Mail this copy to Board of Water Commissioners 429 Miss. St. Jackson, Miss