

OF WATER COMMISSIONERS

LEAKE

223

WATER WELL DRILLERS LOG

CODED

Date: 4-21-61, 1961, Driller: J P Thornton County Leake

(Name)

(1) Owner of Land: Howard Collins
(Name)

14 108
(Address)

(2) Location: 1/4, 1/4, Sec. T R
8 miles SE of College
(distance) (direction) (Nearest Town)

(3) Topography: Level
(Hilly) (Flat) (Level)

(4) Purpose of Well: Domestic
(Domestic Irrigation
Municipal, Industrial, Other)

Description & Color of Materials
Sand, Clay, Red Clay, Shell, etc.

Thick-
ness
Feet

Depth
Feet

Clay 20
white sand 22

1553

Information upon completion of well:

(1) Diameter 2 inches.

(2) Total Depth 42 feet.

(3) Water Level 20 feet below top of ground.

(4) Cased to 37, Size 2"


(5) Screen: Size 1 1/4, Length 6 ft gauge

(6) Were any formations sealed against pollution?
_____ yes, X no.

If YES depth of formation _____

Why _____

Drillers Remarks: 350 gal per hour

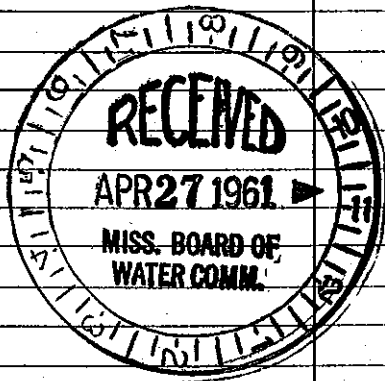

Well No.

(Use Back Side)

Retain this copy for your office files.