

Leake
L-27
68

MISSISSIPPI BOARD OF WATER COMMISSIONERS

WATER WELL DRILLERS LOG

Date: ^{June 7} June 18, 1968, Driller: Thomas Sw County Leake
(When well drilled) (Name) (Where well is located)

(1) Owner of Land: J. H. Taylor
(Name)
Cartage, Miss.
(Address)

(2) Location: SW 1/4, SW 1/4, Sec. 29, T10R8,
3 miles west, of Standing Pine
(distance) (direction) (Nearest Town)

(3) Topography: Hilly (Flat) (Level)

(4) Purpose of Well: Domestic Irrigation
Municipal, Industrial, Other

Description & Color of Materials Sand, Clay, Red Clay, Shell, etc.	Thick- ness Feet	Depth Feet
<u>Red Sandy CLAY</u>	<u>0</u>	<u>30</u>
<u>Dry SAND</u>	<u>30</u>	<u>75</u>
<u>Course SAND</u>	<u>75</u>	<u>96</u>

Information upon completion of well:

(1) Diameter 2 inches.

(2) Total Depth 96 feet.

(3) Water Level 75 feet below top of ground.

(4) Cased to 90, Size 2"
3 slot

(5) Screen: Size 1 1/4, Length 6'

(6) Were any formations sealed against pollution?
_____ yes, NO no.

If YES depth of formation _____


Why _____

Drillers Remarks: _____

Yield in gpm: 7

Size pump: 1 H.P.

Type power: Elec

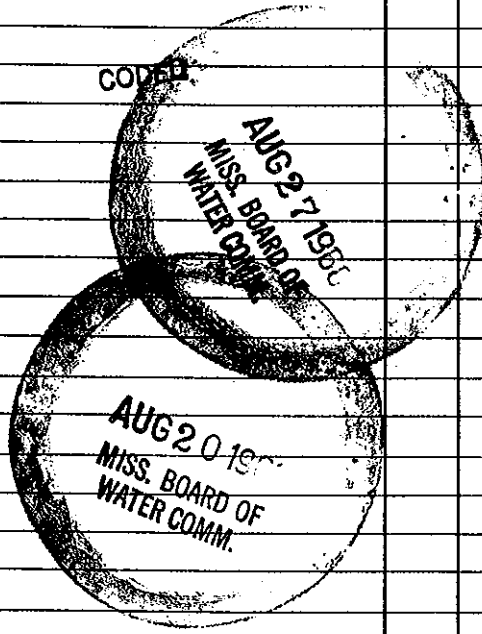

Mail this copy to Board of Water Commissioners 429 Miss. St. Jackson, Miss.