

3

13T

324502ND 0893019

CODED

TEWN

Leske
L29
7-27-68

MISSISSIPPI
 BOARD OF WATER COMMISSIONERS
 416 North State Street
 Jackson, Mississippi 39201

WATER WELL DRILLERS LOG

7-27 date well completed
J.P. Thornton firm name
Leske county well located


LANDOWNER: Mr. Otho Heel
Carthage
Bte 8
 (mailing address)

WELL LOCATION:
 sec. 5 T. 10 N. R. 9 E
 S W
 (distance) miles (direction) of (nearest town)

WELL PURPOSE: home
 (home, irrigation, municipal, industrial)

- WELL COMPLETION DATA:
- (1) diameter (inches) 2'
 - (2) total depth (feet) 297
 - (3) static water level (feet) 65' below above top of ground.
 - (4) casing galv, 292,
 (material) (depth)
 (size) if telescope see back.
 - (5) screen 5',
 (length) (depth to top)
2 1/2", SS
 (size) (material)
 - (6) pump 2 HP ent 8 gpm
 (HP) (yield gpm)
 (type power)
 - (7) electric log (yes or no)
 (organization running log)
 - (8) how well bottom plugged seam

description of formations encountered	from	to
<u>Clay Red</u>	<u>35'</u>	
<u>dry sand + cl. caps</u>	<u>50</u>	
<u>dry coarse sand</u>	<u>40</u>	
<u>Black bit rock</u>	<u>85</u>	
<u>shell + Black sand</u>	<u>4</u>	
<u>Black sand</u>	<u>50</u>	
<u>gray water sand</u>	<u>10</u>	
	<u>23</u>	
	<u>297</u>	

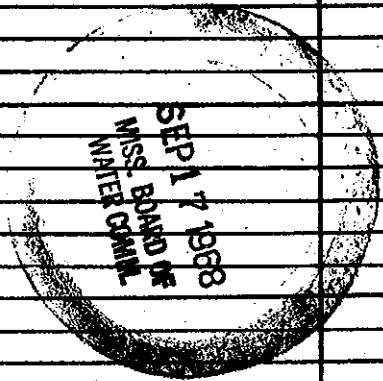

DRILLERS REMARKS: