

3

13T

324000N0892900

Leake
L 30
9-30-68

MISSISSIPPI
 BOARD OF WATER COMMISSIONERS
 416 North State Street
 Jackson, Mississippi 39201

CODED TEWN

WATER WELL DRILLERS LOG

9-30 1968 Thomasson Leake
 date well completed firm name county well located

LANDOWNER: Mr. Ross Craine
Carthage, Miss
 (mailing address)

WELL LOCATION:
 sec. 33 T. 10 N R. 8 E
 S W
4 miles S.E. of Carthage
 (distance) (direction) (nearest town)

WELL PURPOSE:
 (home, irrigation, municipal, industrial)

WELL COMPLETION DATA:

(1) diameter (inches) 2

(2) total depth (feet) 392

(3) static water level (feet) 105 ^{below} _{above} top of ground.

(4) casing Galv. 252
 (material) (depth)
2'
 (size) If telescope see back.


(5) screen Open
 (length) (depth to top)
 (size) (material)

(6) pump 2 7
 (HP) (yield gpm)
Elec
 (type power)

(7) electric log no
 (yes or no)
 (organization running log)

(8) how well bottom plugged

description of formations encountered	from	to
DIRT	0	10
CHALK	10	50
Chalk & Sand	50	84
White Sand	84	112
Hard Black Lignite	112	122
SAND	122	244
Black Dirt	244	330
Mostly Fore Run	330	355
Little Rock & Shell		
Hard Rock & Shell	355	359
Green Sand	359	385
Coarse Grey Sand	385	392

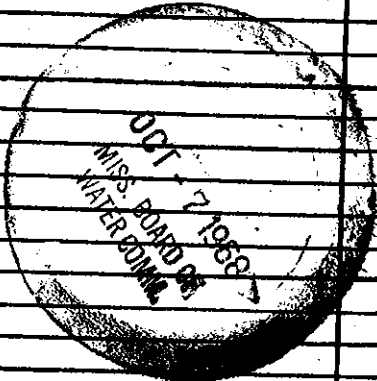

DRILLERS REMARKS: